VOL 1202 PAGE 806

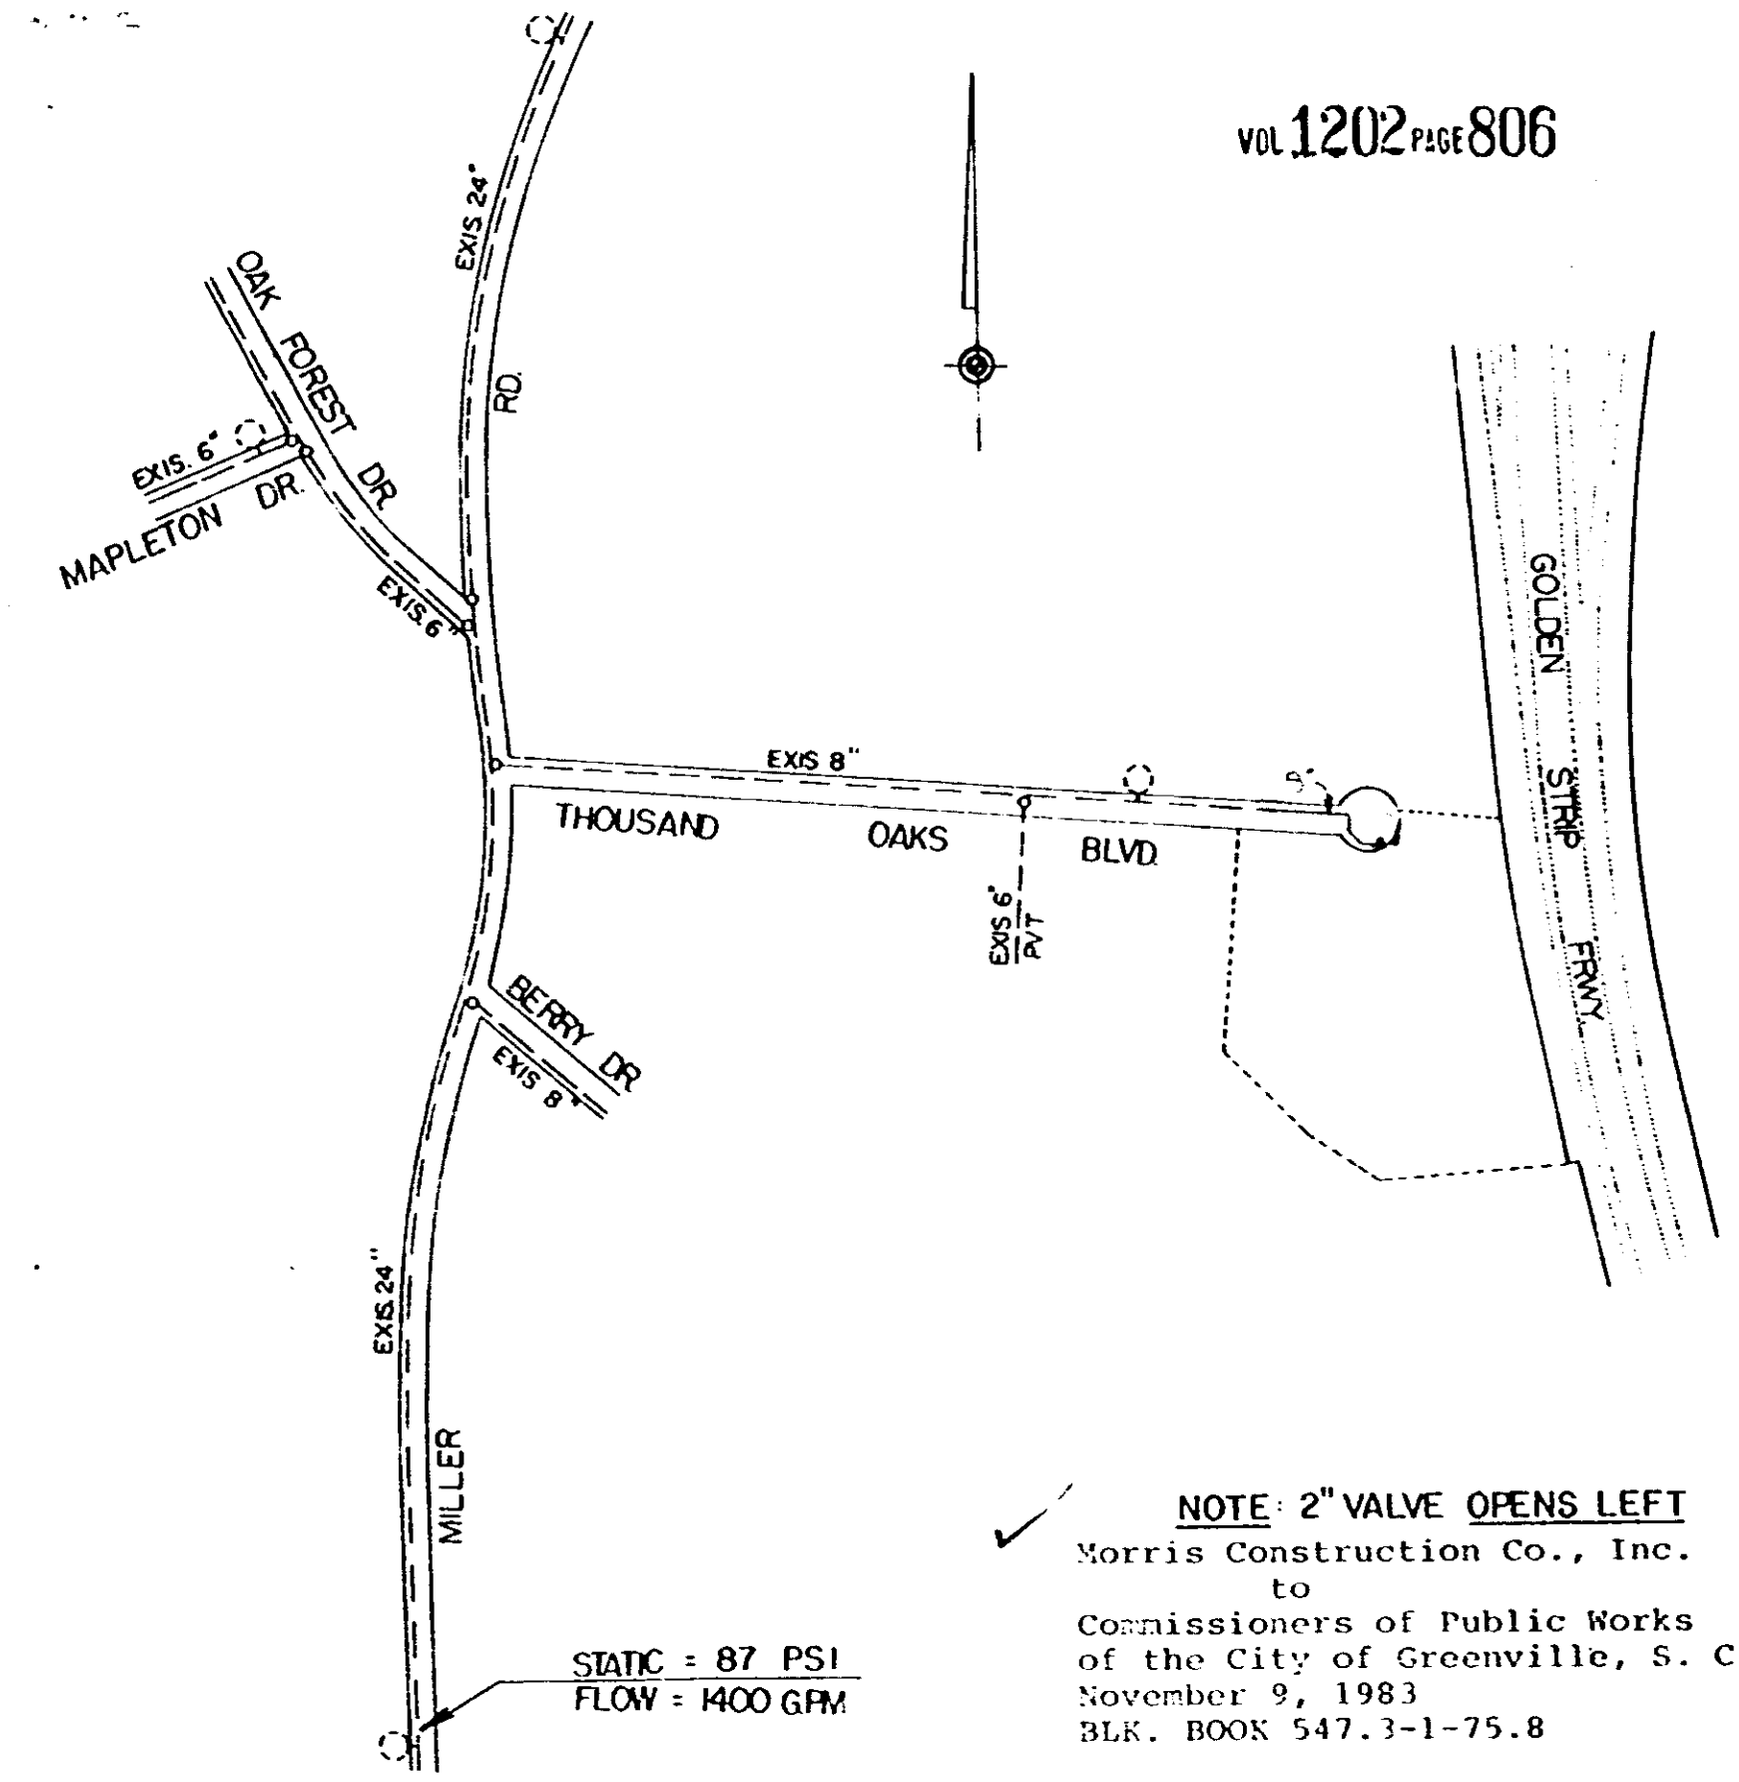

NOTE: 2" VALVE OPENS LEFT

Morris Construction Co., Inc.
to
Commissioners of Public Works
of the City of Greenville, S. C.
November 9, 1983
BLK. BOOK 547.3-1-75.8

MATERIAL LIST:

8" D. I. Pipe	-	298'±
2" Valve	-	1
Valve Box	-	1

THOUSAND OAKS BLVD. EXT.
SEPT, 1983 SCALE: 1" = 400'

19604

RECORDED DEC 20 1983 at 3:21 P.M.