VOL 1205 PAGE 810

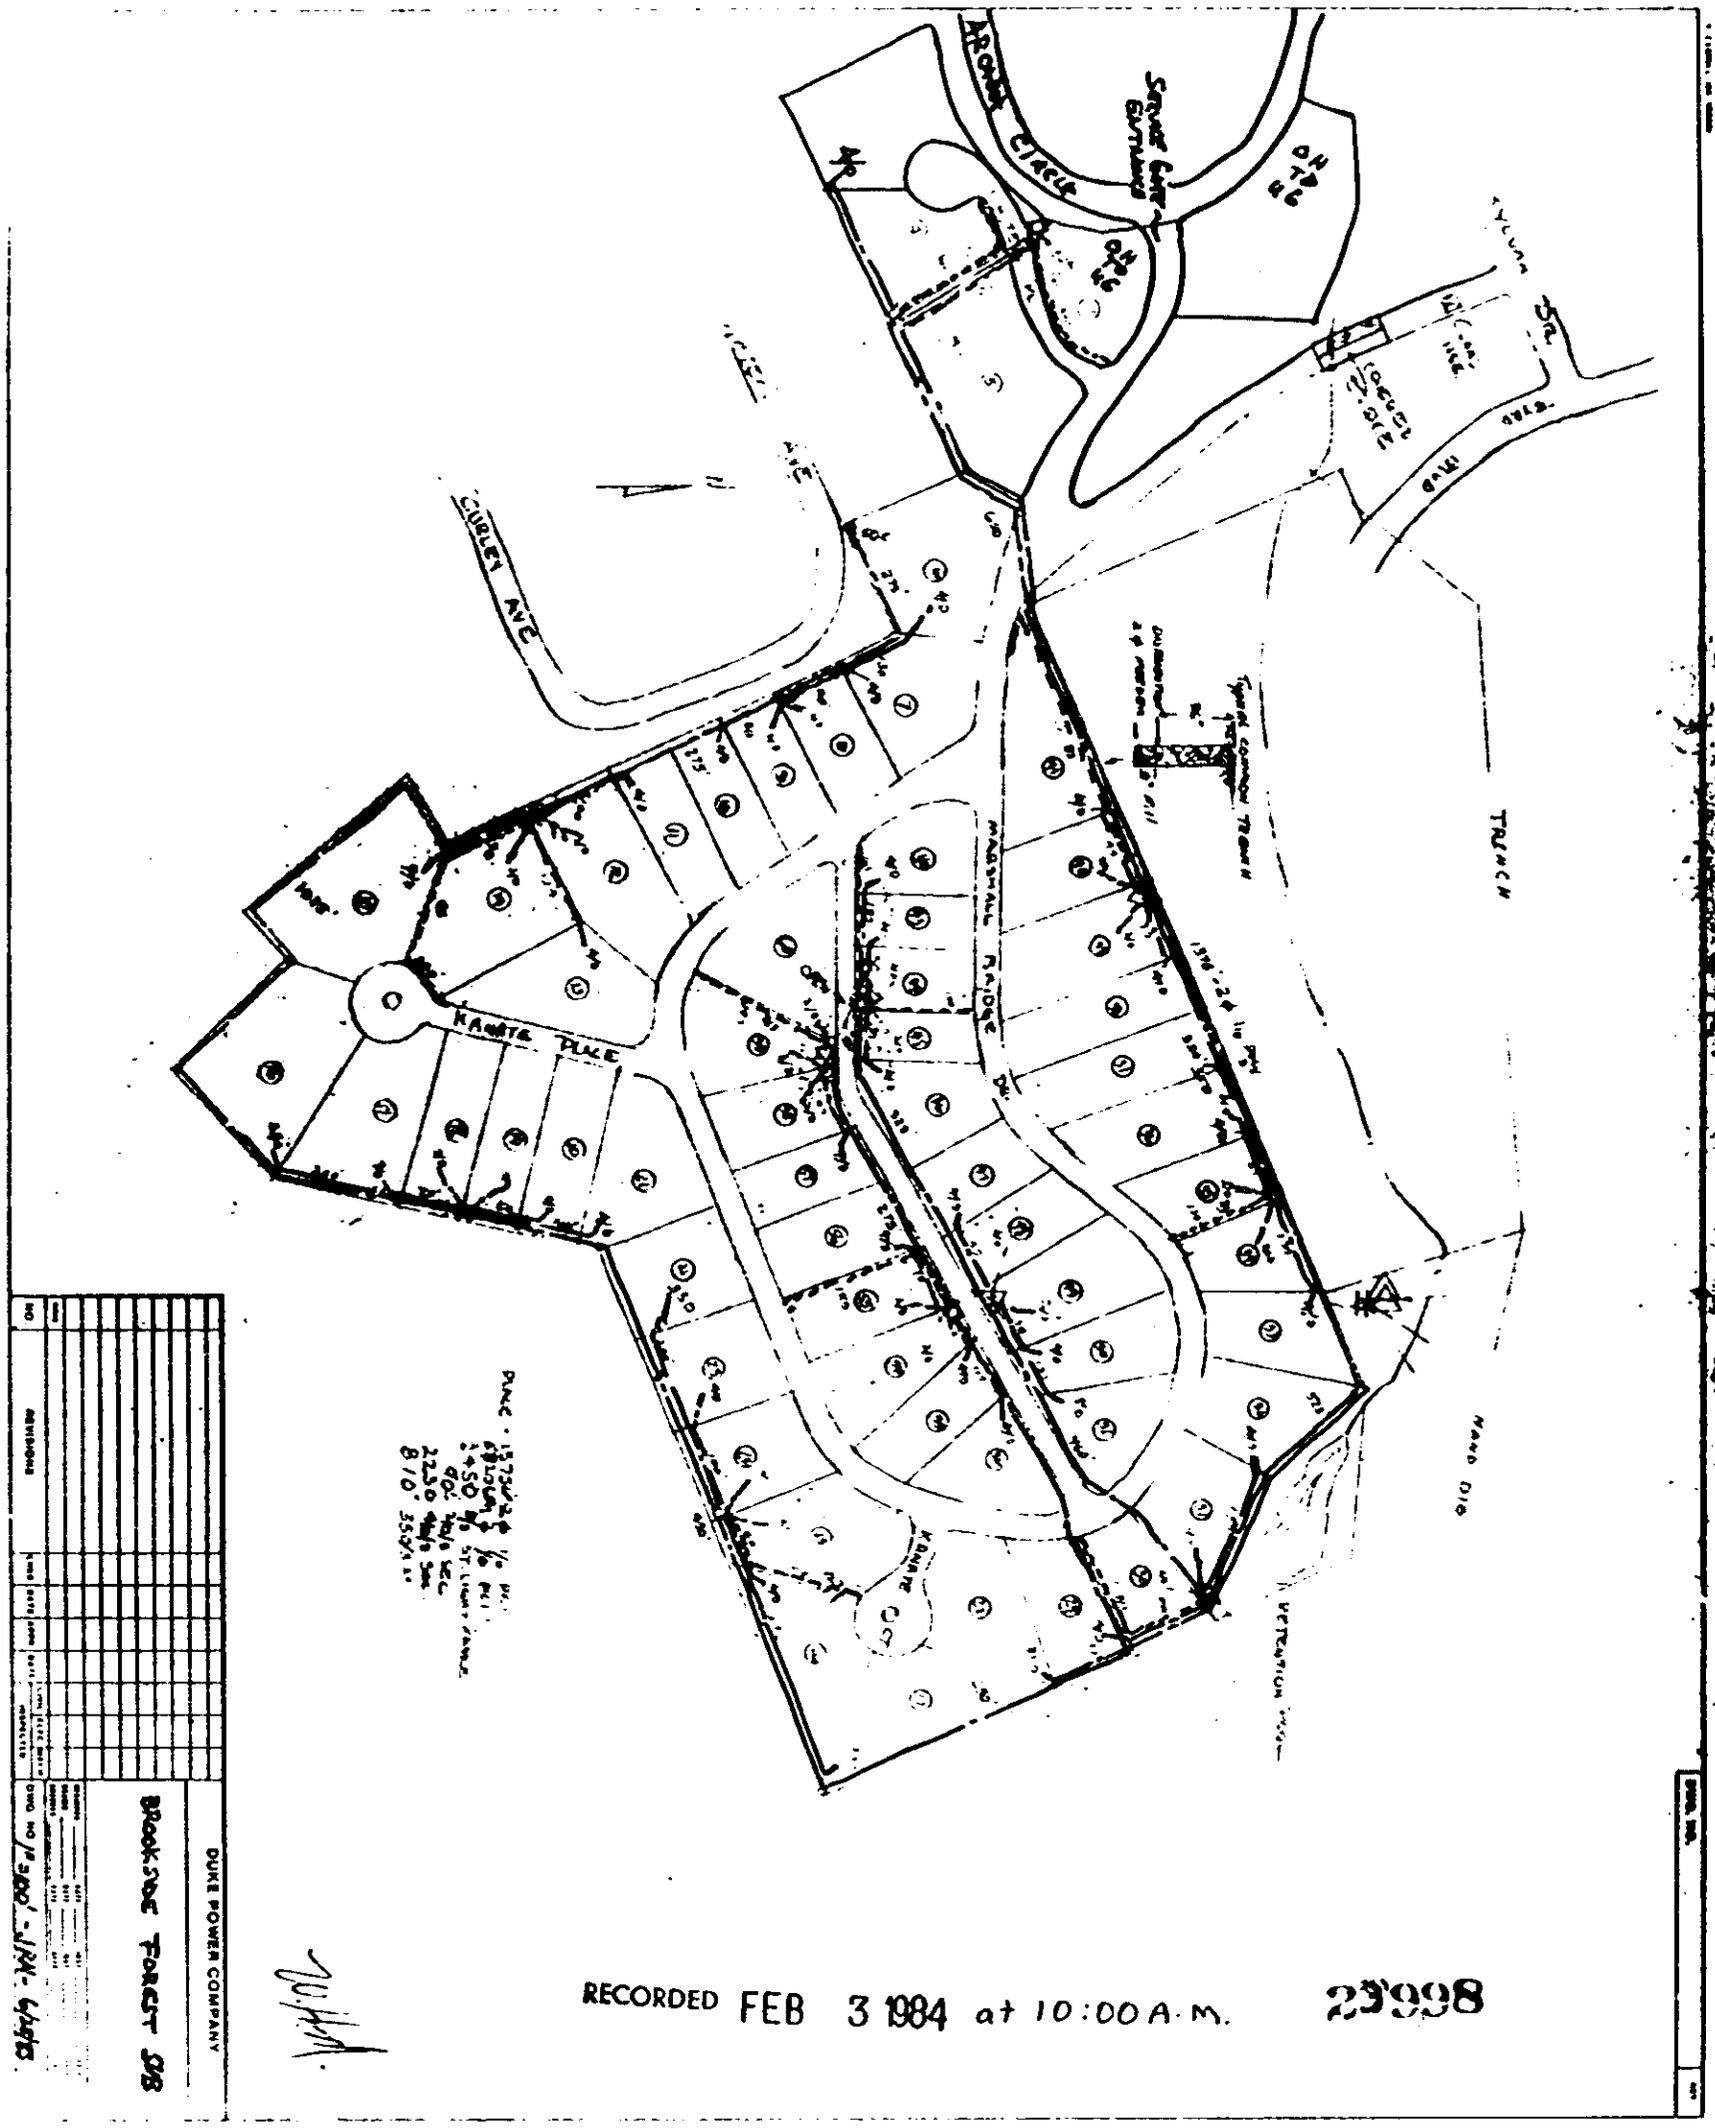

RECORDED FEB 3 1984 at 10:00 A.M. 23998

FILED
FEB 3 1984
at 10:00 A.M.
23998