


LIMITED COMMON ELEMENTS

EXHIBIT A

VEL 1209 PAGE 418

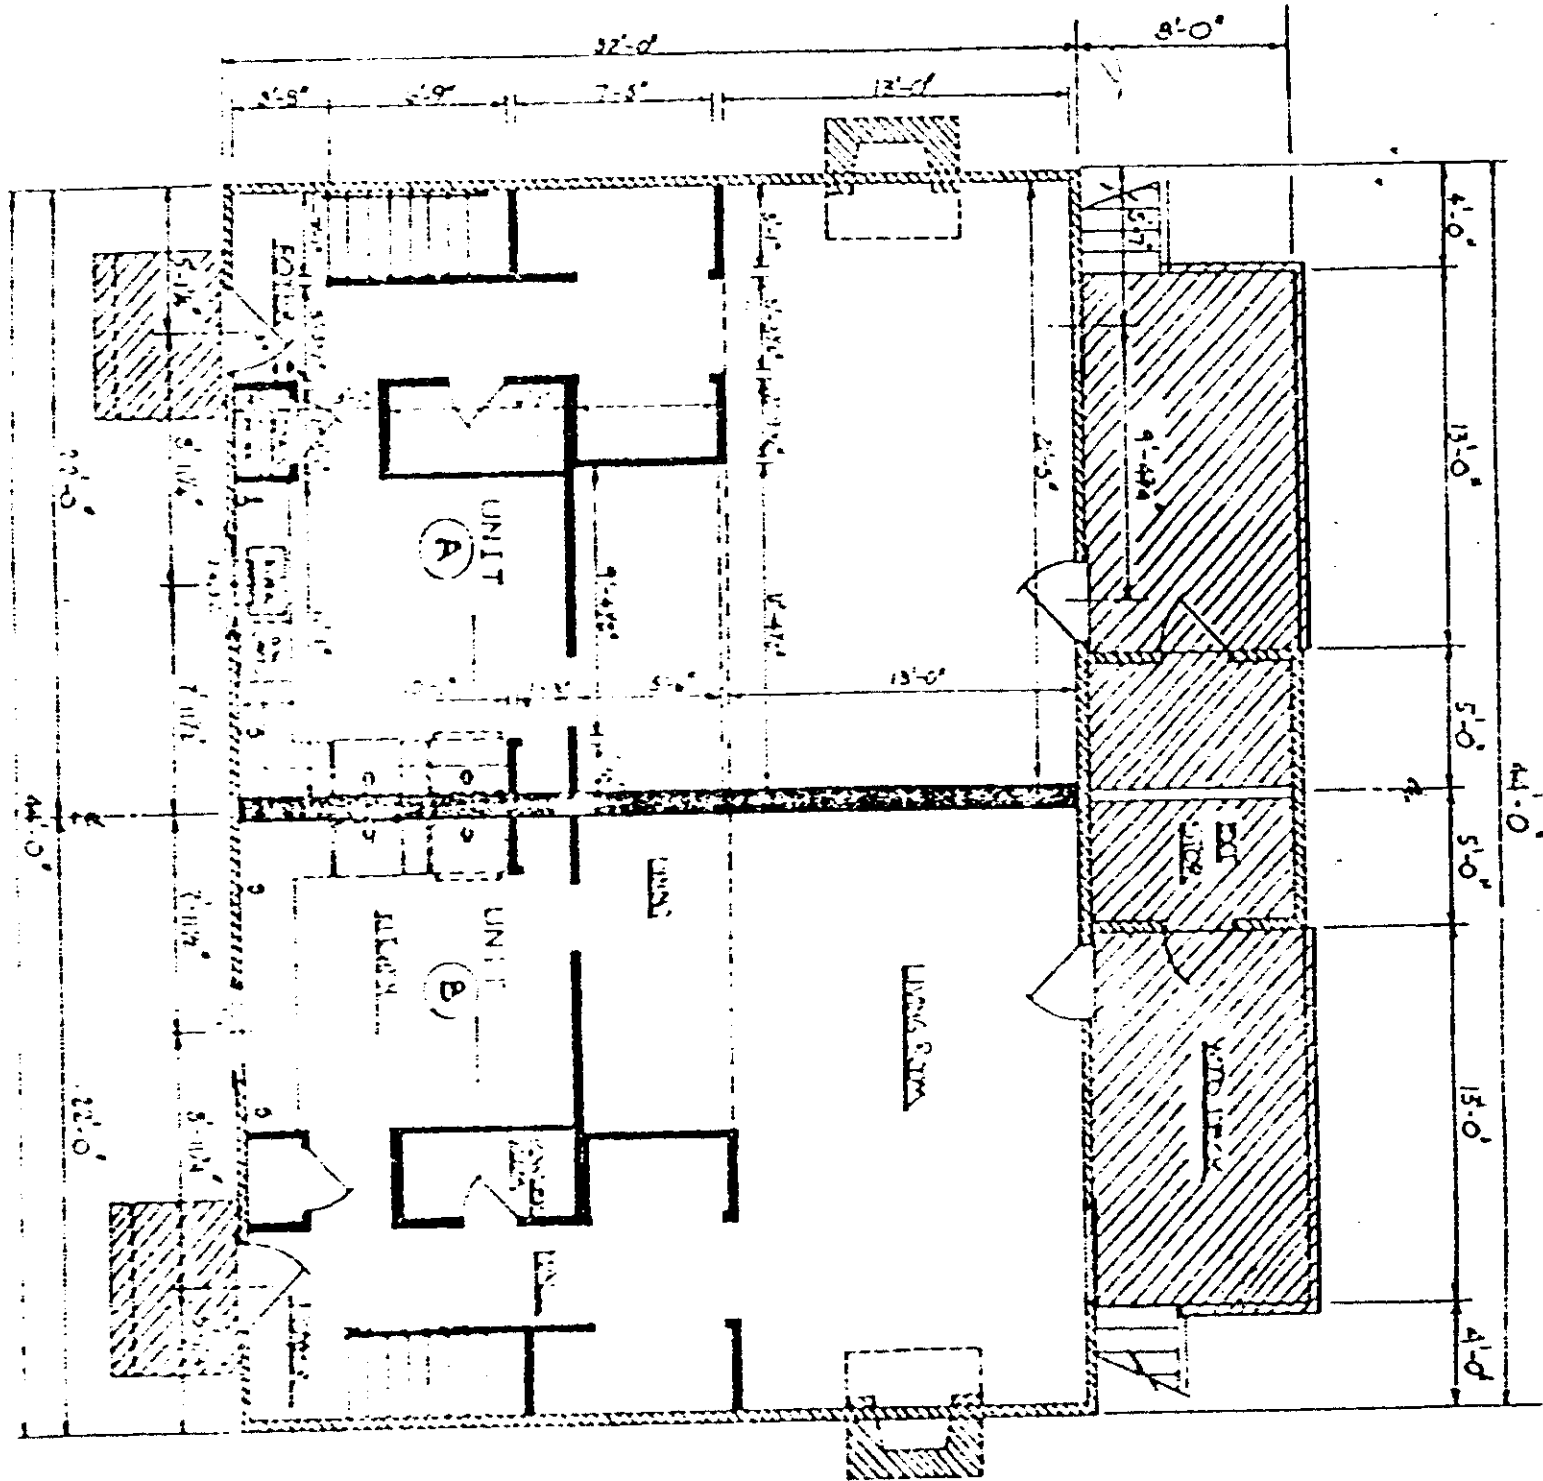

CERTIFICATE

I, Wade H. Barber, do hereby certify that these plans fully depict within reasonable construction tolerances the layout, location, letter identification, and dimensions of the buildings and dwellings contained therein.

*Wade H. Barber*

