


9 7 0 6

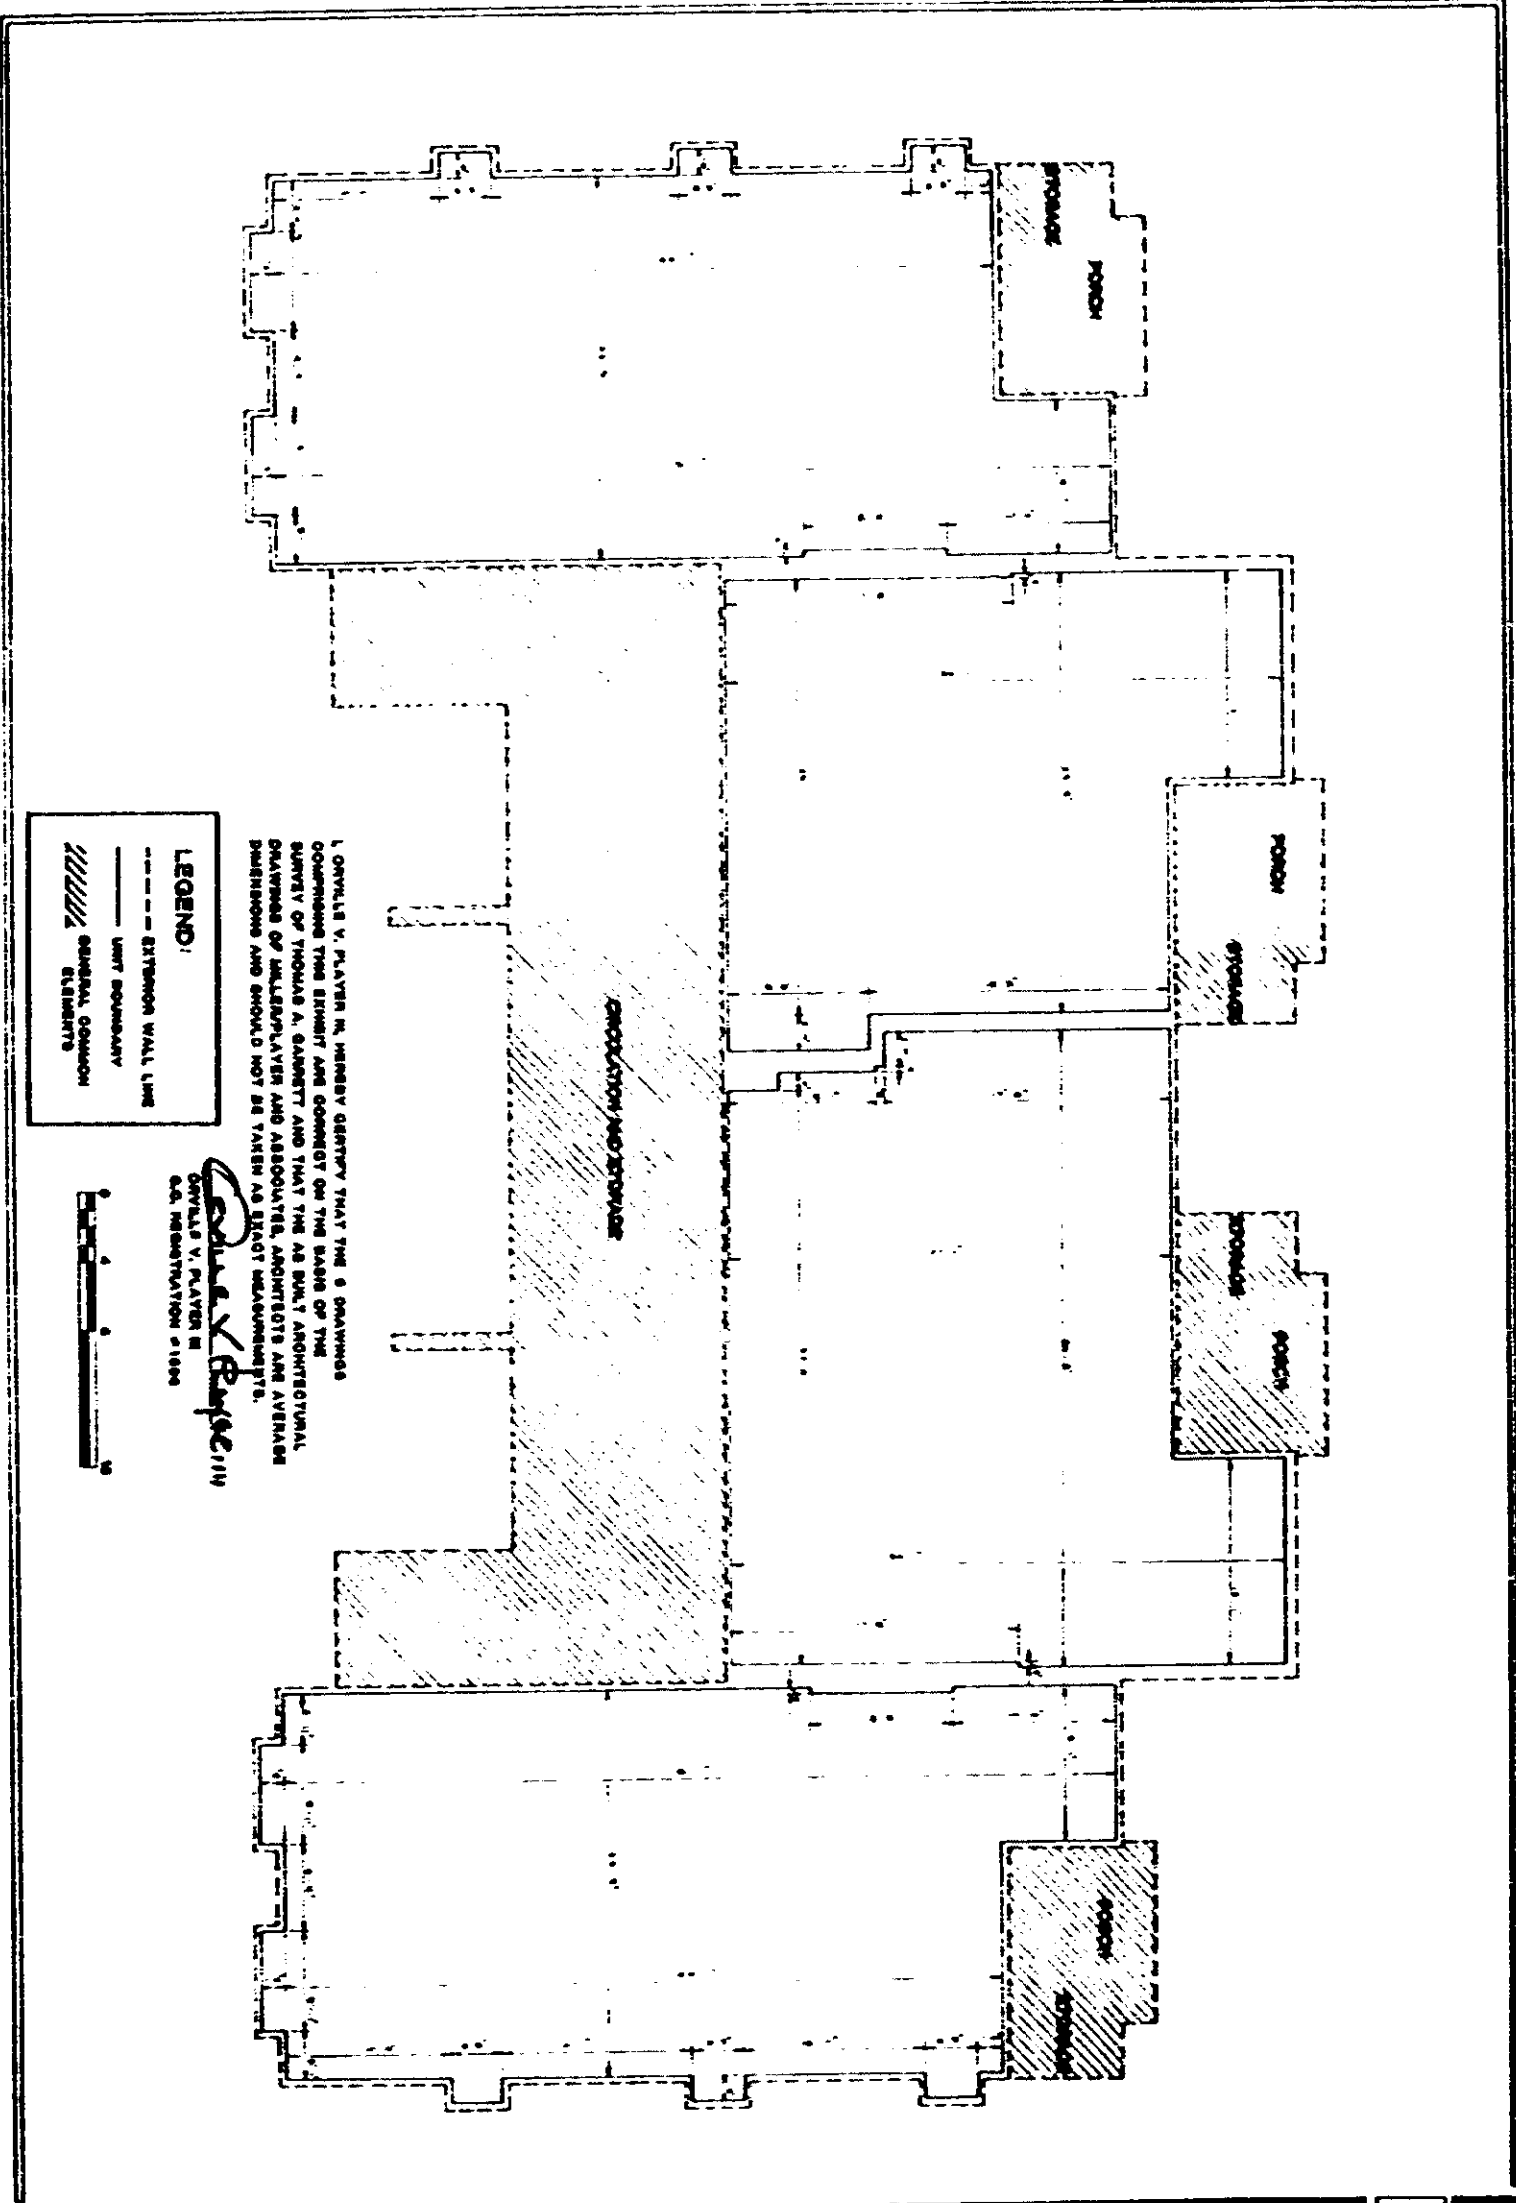

**LEGEND:**

UNIT BOUNDARY

COMMON ELEMENTS

EXTENSION WALL LINE


*Orville V. Player III*  
 ORVILLE V. PLAYER III  
 A.S. REGISTRATION # 11888



EXHIBIT B  
 PAGE 8

CREEKSIDE  
 HORIZONTAL PROPERTY REGIME  
 THIRD FLOOR PLAN

DATE	DESCRIPTION

**MILLER/PLAYER & ASSOCIATES**  
 ARCHITECTS AND PLANNERS, LTD.  
 1010 east north street - greenville, S.C.  
 James B. Miller, A.S.A. / Orville V. Player, III / Robert C. Collier



4328-KY-2