


**B E B O**


503, 507, 606, 610, 707, 711

**UNIT 'K'**


**FOUNDATION PLAN**

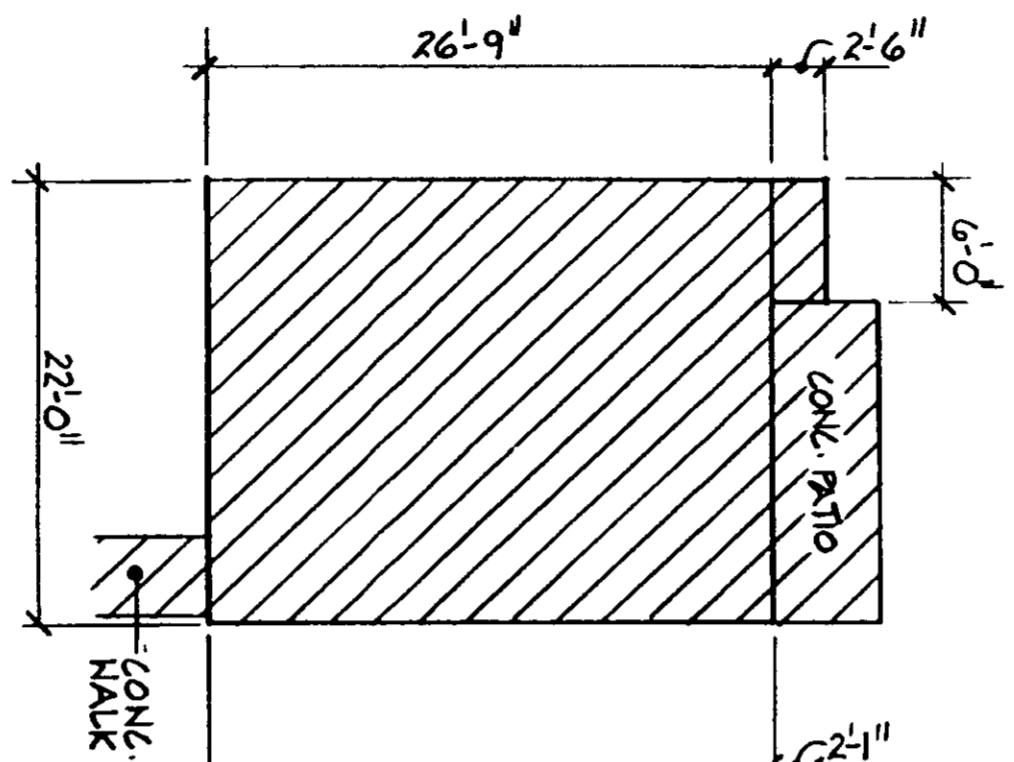

**FIRST FLOOR PLAN**

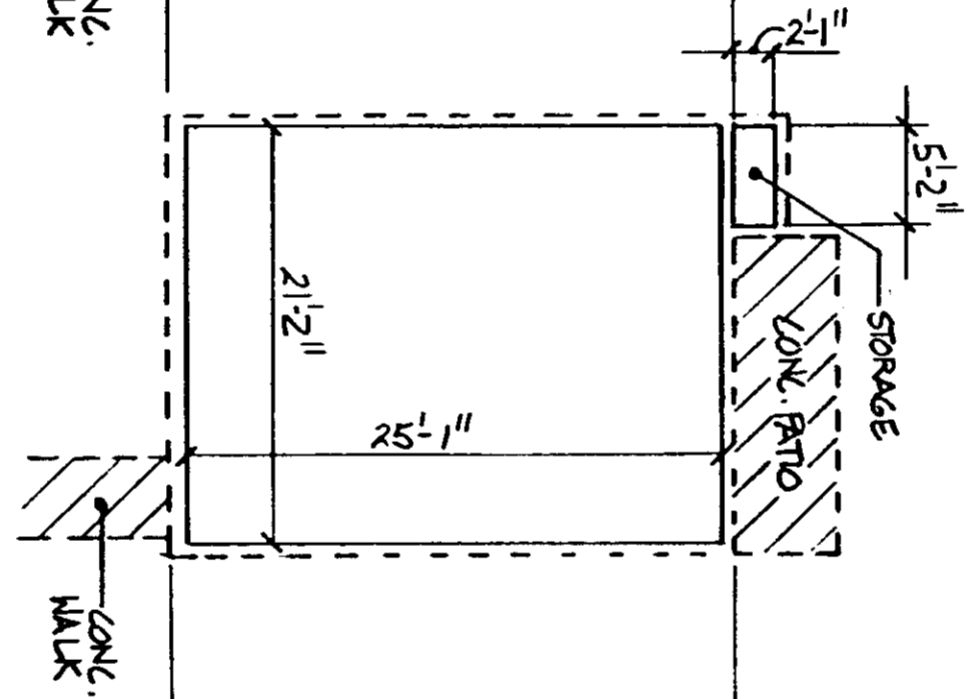

**SECOND FLOOR PLAN**

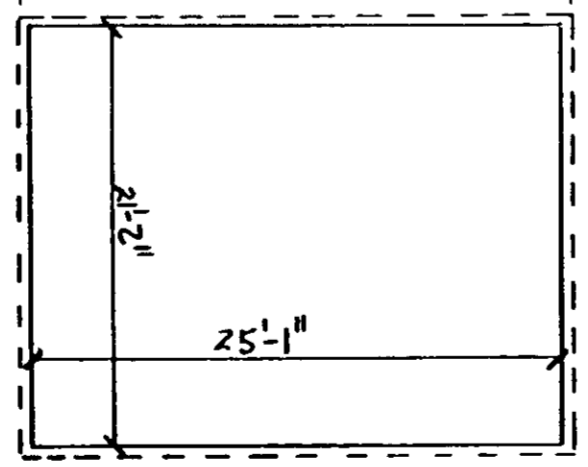

**LEGEND**

- UNIT BOUNDARY
- GENERAL BOUNDARY
- STAIRWAYS
- UNITED COMMON ELEMENTS
- RATIO - SECTORS UNCOVERED AREA
- CONC - CONCRETE CONCRETE SLABS ON GRADE CONSTRUCTION

M. WILLIAM SAWYER JR., NEEDED CERTIFY THAT THE WITHIN FLOOR PLANS ARE TRUE AND CORRECT TO THE BEST OF MY KNOWLEDGE  
 M. WILLIAM SAWYER JR.  
 SEC REGISTRATION # 1088



4328 (7-2)