


REB 5


509 703

UNIT 'U'


FOUNDATION PLAN

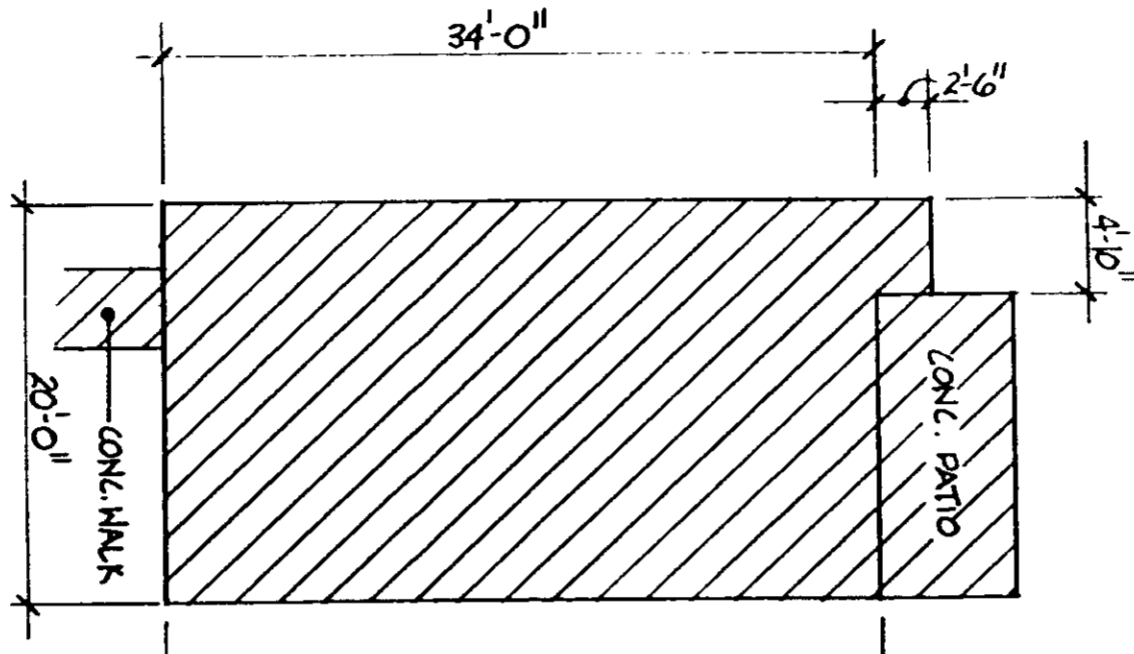

FIRST FLOOR PLAN

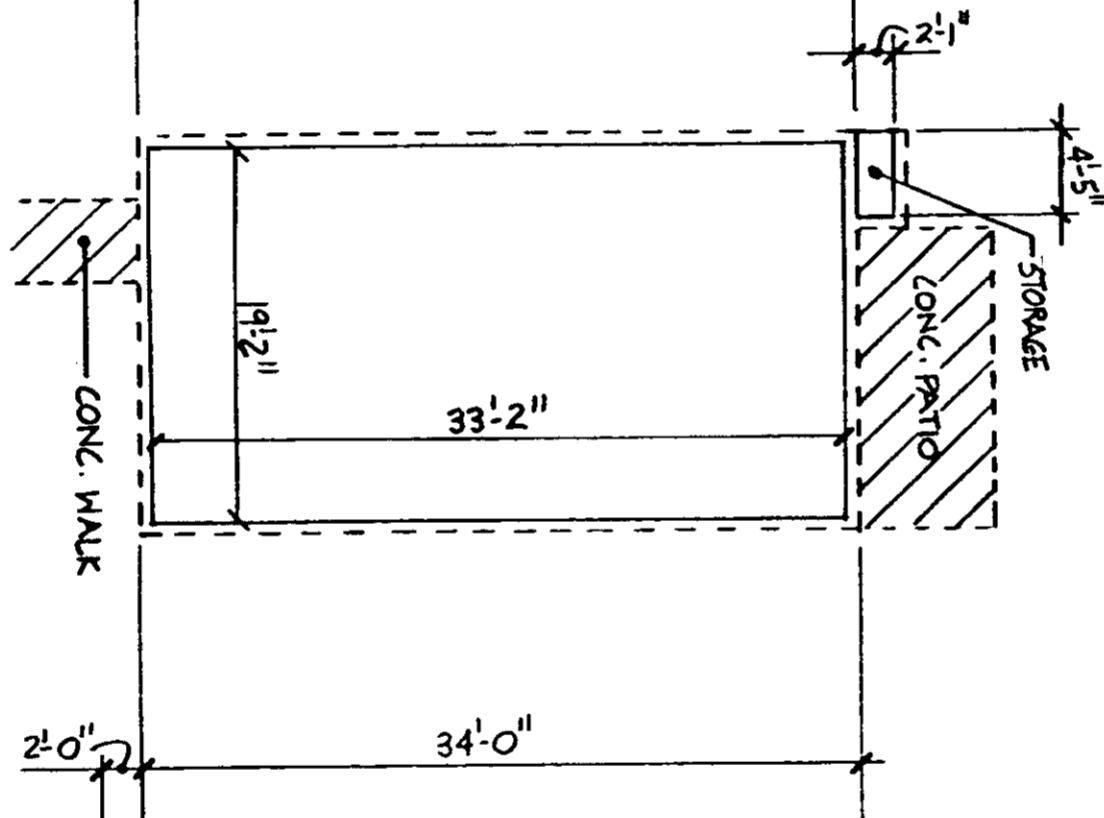

SECOND FLOOR PLAN

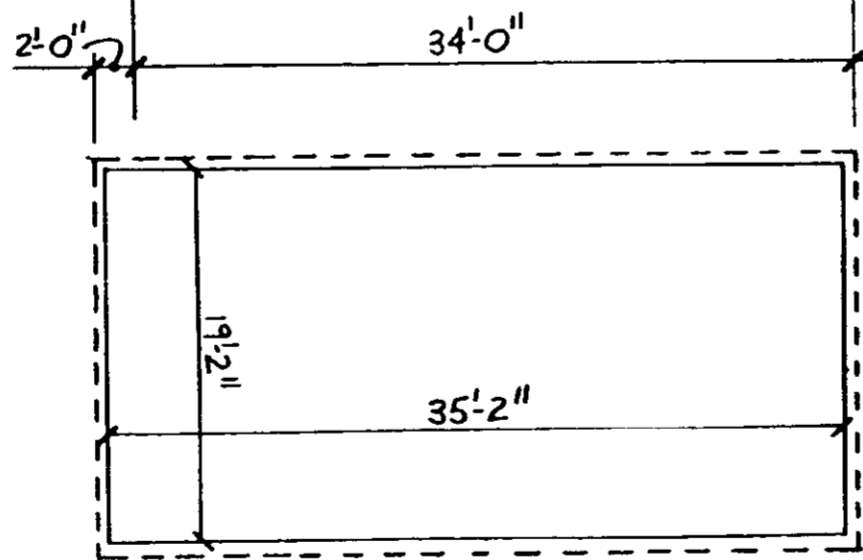

LEGEND

—	UNIT BOUNDARY
- - -	GENERAL BOUNDARY

I, M. WILLIAM BAKER, JR., HEREBY CERTIFY THAT THE WITHIN FLOOR PLANS ARE TRUE AND CORRECT TO THE BEST OF MY KNOWLEDGE.  
M. WILLIAM BAKER, JR.  
SC REGISTRATION # 10888



4328 RV.21