

Name and Post Office Address of Grantor Milton Trotter, III  
Route 14  
Greenville, South Carolina 29605

Toll Line or Exchange Line tributary to Greenville, South Carolina  
(Name)  
(Exchange)


The Property is bounded where the line enters and leaves this property by the property of:  
SEE SKETCH on the \_\_\_\_\_  
 and \_\_\_\_\_ on the \_\_\_\_\_

Authority C 8518 Classification 45-C

Area SOUTH CAROLINA

Approved 222/lae

Title gny Engineering Manager  
NORTH

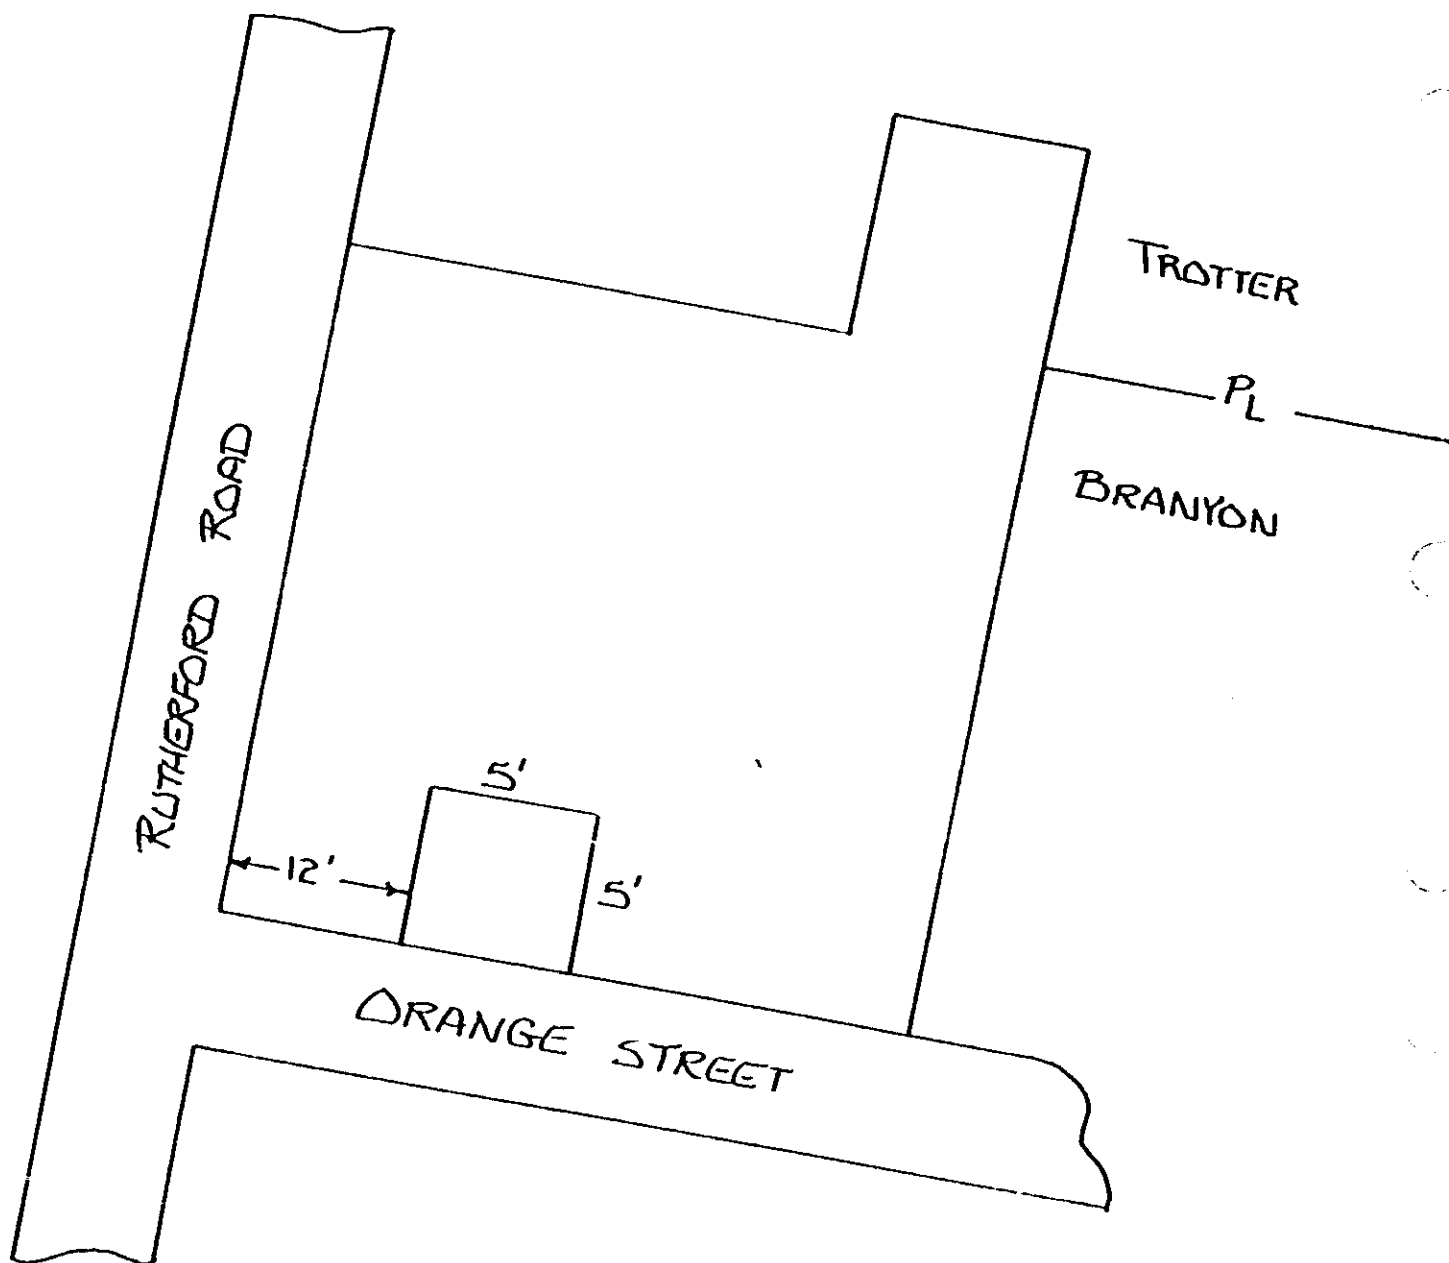

RECORDED JAN 3, 1985 at 2:01 P/M

19820

Maid - Dec 29, 1985  
1985  
X19820

Filed for record in the office of  
 the R. M. C. for Greenville  
 county, S. C. at 2:01 o'clock  
 P/M Jan. 3, 1985  
 and recorded in Deed Book  
 1230 at page 345  
 R. M. C. for G. Co. S. C.

1230

1230-8237