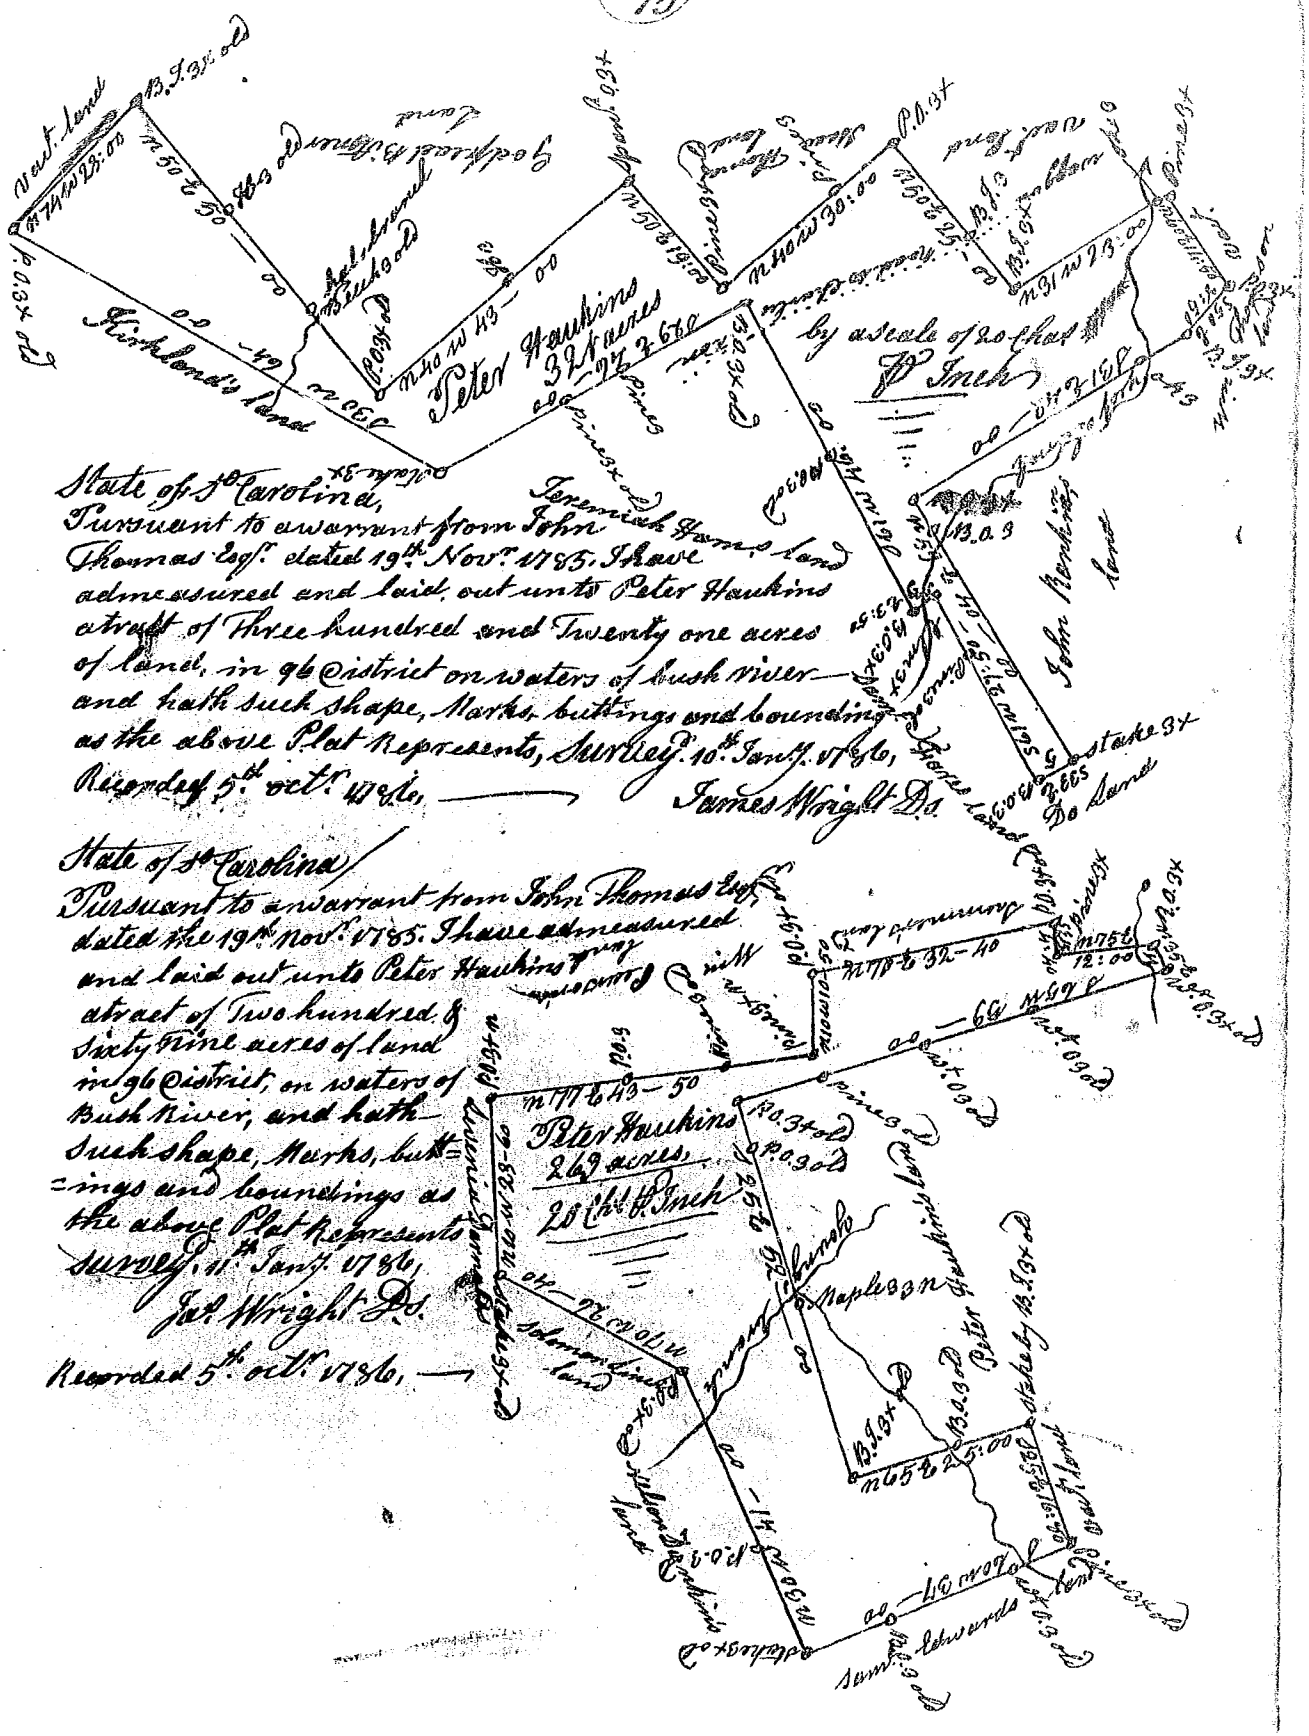

State of N. Carolina,
Pursuent to a warrant from John Thomas Esq.r dated 19th Nov.r 1785. I have admeasured and laid out unto Peter Hawkins a tract of three hundred and twenty one acres of land in 96 District on waters of Bush river and hath such shape, Marks, buttings and boundings as the above Plat Represents, Survey.d 10th Jan.y 1786,
Recorded 5th oct.r 1786, ——

James Wright D.S

State of N. Carolina
Pursuent to a warrant from John Thomas Esq.r dated the 19th Nov.r 1785. I have admeasured and laid out unto Peter Hawkins a tract of Two hundred & sixty nine acres of land in 96 District, on waters of Bush River, and hath such shape, Marks, buttings and boundings as the above Plat represents
Survey.d 11th Jan.y 1786,
Jas. Wright D.S.
Recorded 5th oct.r 1786, —