



State of South Carolina
 Pursuant to a warrant laid out to David Morgan from John Thomas Esq. Comr. of locations dated 25th Dec^r 1786, I have admeasured and laid out unto William Gurey a tract of two hundred acres of land, in 96 District, Laurens County, on a branch of Neburn's Creek, called Mountain Creek, and hath such shape, Marks, buttings and boundings as the above Plat represents, Survey^d 15th Jan^y 1787, Recorded 18th Jan^y 1787, Det. self
 Jonathan Downs De.

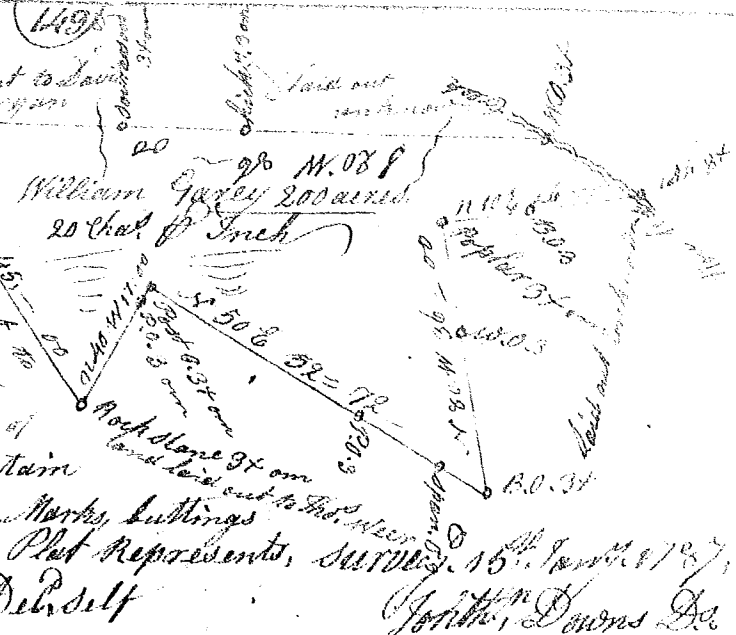

State of S^c Carolina
 Pursuant to a warrant from John Thomas Esq. Comr. of loc^s Dated 25th Dec^r 1786, I have admeasured and laid out unto Charles Gurey a tract of two hundred acres of land in 96 District Laurens County on a branch of Neburn's Creek call. Lick Creek, and hath such shape, Marks, buttings and boundings as the above Plat represents, Survey^d 12th Jan^y 1787, Recorded 18th Jan^y 1787, Det. self
 Jonathan Downs De.

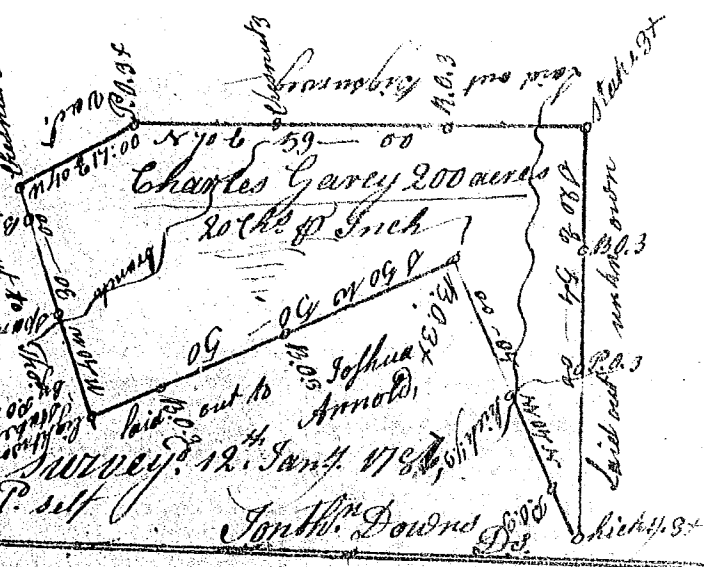

State of South Carolina
 Pursuant to a warrant from John Thomas Esq. Comr. of locations, I have admeasured and laid out unto Nicholas Bleigh a tract of one hundred and seven acres of land in 96 District on the waters of Lamm's Creek, and hath such shape, Marks, buttings and boundings as the above Plat represents, Survey^d 30 Aug^t 1786, Recorded 19th Jan^y 1787, Det. Jonathan Downs De.

