


(169)

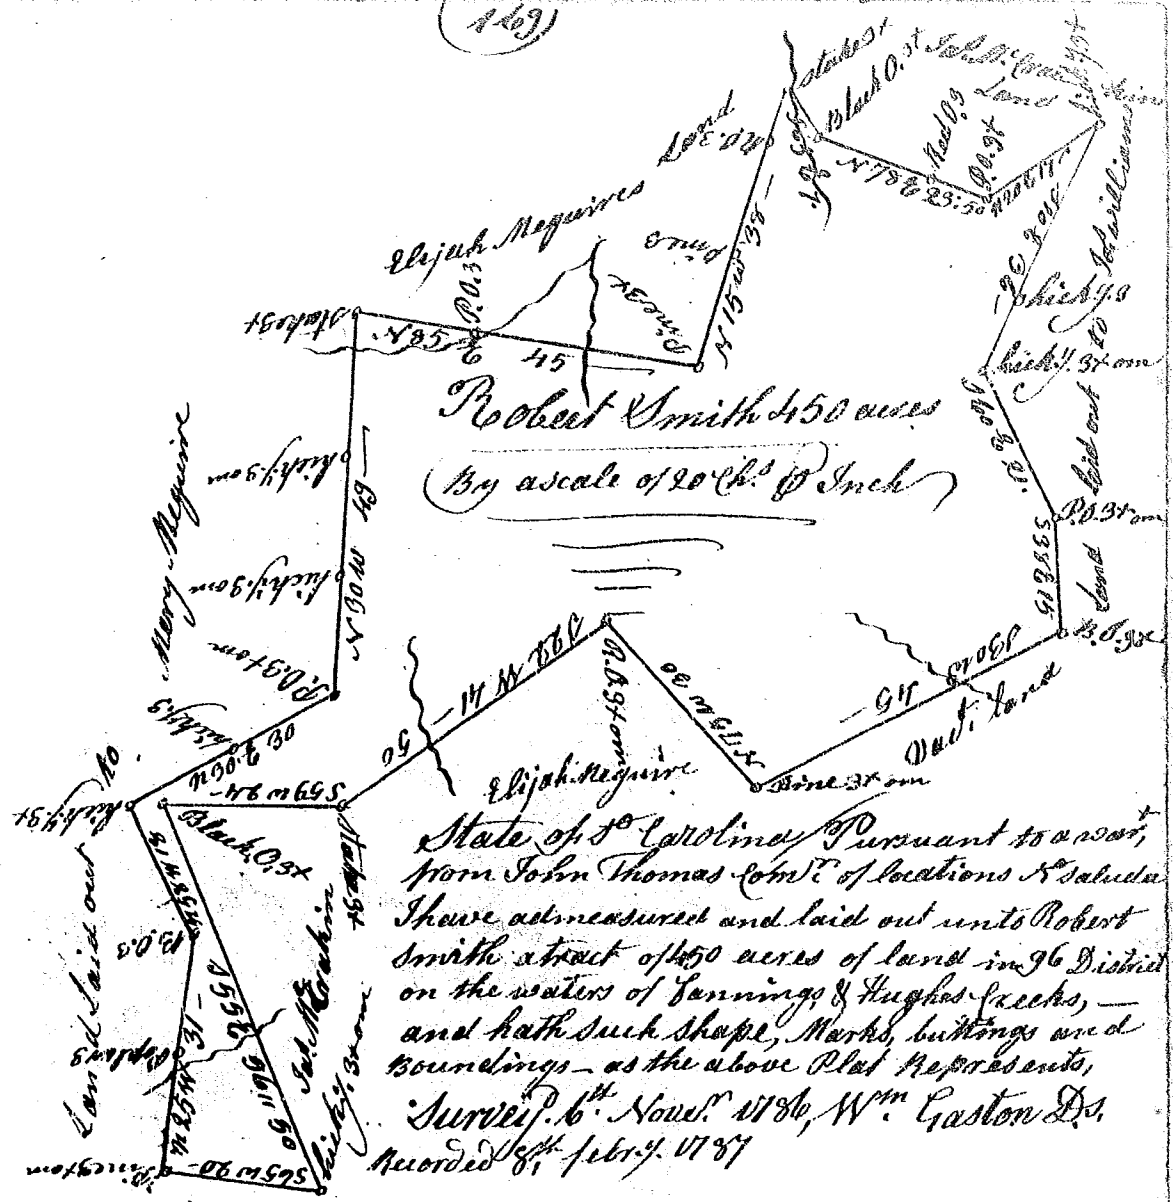

Robert Smith 450 acres
 (By a scale of 20 Ch. & Inch)

State of S^c Carolina Pursuant to a warrant from John Thomas Com^r of locations & Saluda I have admeasured and laid out unto Robert Smith a tract of 450 acres of land in 96 District on the waters of Lanningo & Hughes Creeks, — and hath such shape, Marks, buildings and boundings — as the above Plat Represents, Surveyed 6th Nov^r 1786, W^m Gaston D^s. Recorded 8th Febr^y 1787