State of S. Carolina 96 Dist.

Pursuant to a warrant from John Thomas Esqr. Commr. Locations dated the 6th Apl. 1787. I have admeasured & laid out unto John Thompson a tract of 560 acres of Land. Situate lying & being in Union County on both sides of Thicketty Creek & Between Broad and Pacolet Rivers. Such form marks Buttings & Boundings as the above Plat Represents Surveyed 10th Apl. 1787

And. Thomson D.S.

Recorded 4th June 1787

Del. Lib

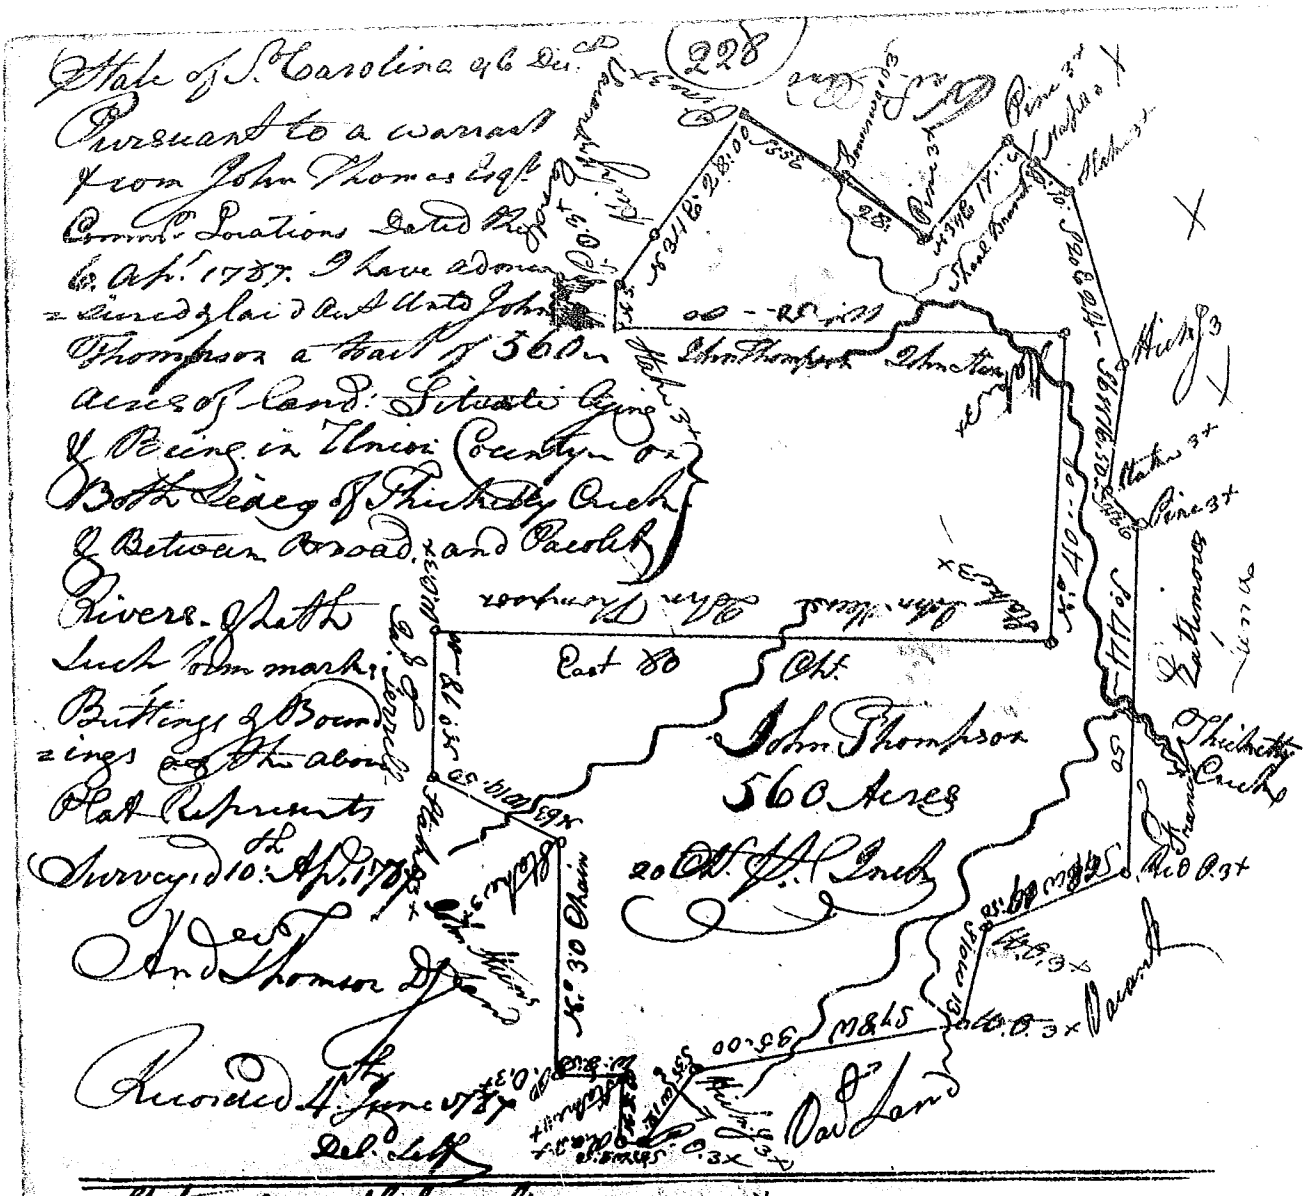
John Thompson
560 Acres
East 80 Ch.
20 Ch. 1/4 Inch
Pine 3x
Hickory 3x
Maple 3x
Stake 3x
Pine Stump 3x
Pine Stump 3x
Pine 3x
Hickory 3x
Maple 3x
Pine 3x
Hickory 3x
Pine 3x
Pine 3x
Pine