

State of South Carolina
 Pursuant to a warrant
 from John Thomas Esq.
 Comr. of locations, I have
 admeasured and laid out
 unto George Stoddinor
 a tract of five hundred acres of land, & land
 in 96 district on the waters of Crims creek, and both such shape, marks, boundaries,
 and boundings as this plat represents. Recorded 18th April 1788, Del. F. Wadsworth, — James Dougherty, D.S.


George Stoddinor
 Wadsworth 18th April 1788.
 500 Acres.
 Scale, 20 ch. to 1 Inch

South 05 — 00

South Carolina, Seneca County, —
 Pursuant to a warrant from John Thomas Esq. Comr.
 of locations, 96 District N. Saluda; I have admeasured
 and laid out unto Lott Wood a tract of 80 acres
 of land on the N. side of Parolat river, bound
 on the N. by Turner Sifson's land, on S. by Lewis
 Turner's land, E. by Parolat river, and both
 such shape & marks as the above Plat represents
 = to. — Certified the 19th April 1788,
 Recorded 21st April 1788. Del. self.



South Carolina Pursuant to a warrant from
 John Thomas Comr. of locations dated 15th day
 of March 1788, I have measured and laid
 out unto Joseph South a tract of land
 containing 500. Situate in Ninety six dist.
 Laurens County N. of Saluda. River on a
 branch thereof call'd Pinsons branch bound
 N. by J. Bright's land and on all other
 sides by Vacant Land, and both such shape
 and marks as the above plat represents
 Surveyed this 30th day of April 1788
 By Jonathan Downs D. S.
 Recorded the 21st April 1788. and del. to self

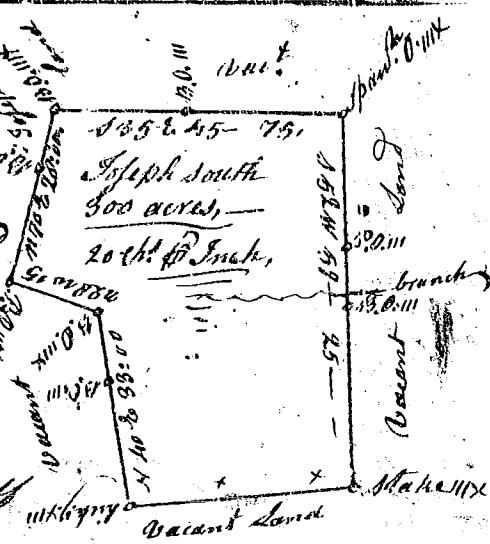

State of S. Carolina Pursuant to a warrant
 from John Thomas Esq. Comr. of locations, dated
 the 15th March 1788 I have admeasured
 and laid out unto Joseph South a tract of
 200 acres of land, situate in 96 dist. Laurens
 County on Great Saluda river bounded
 to the N. by land laid out by J. Thomas
 Esq. by J. Powell's land, and all other sides
 by vacant land, and both such shape, marks,
 shape and boundings as the above plat repre-
 sents, Surveyed the 21st April 1788.
 By Jonathan Downs D. S.
 Recorded the 21st April 1788. and del. to self

