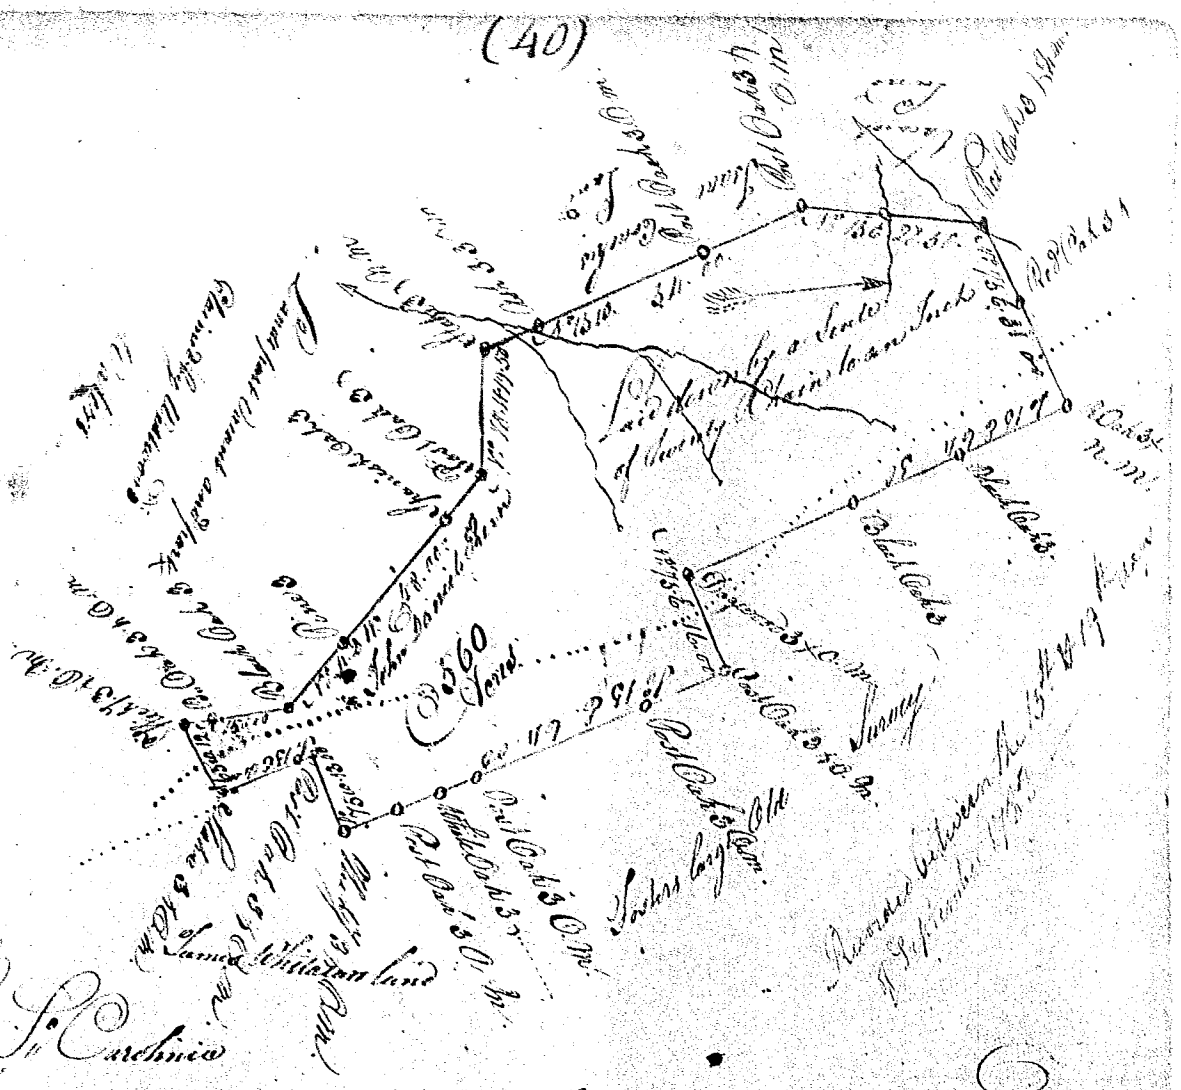
3560 Acres
Land
Pat Oaks
Pat Oaks C.
Pat Oaks C. M.
