






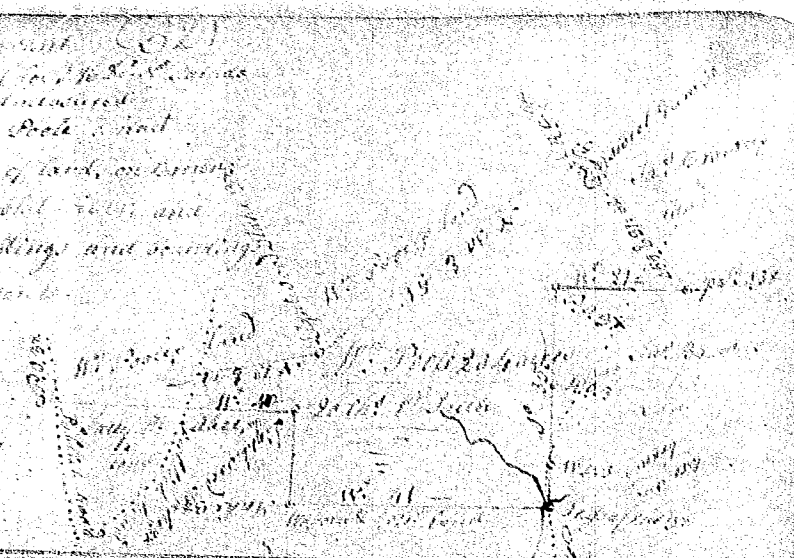




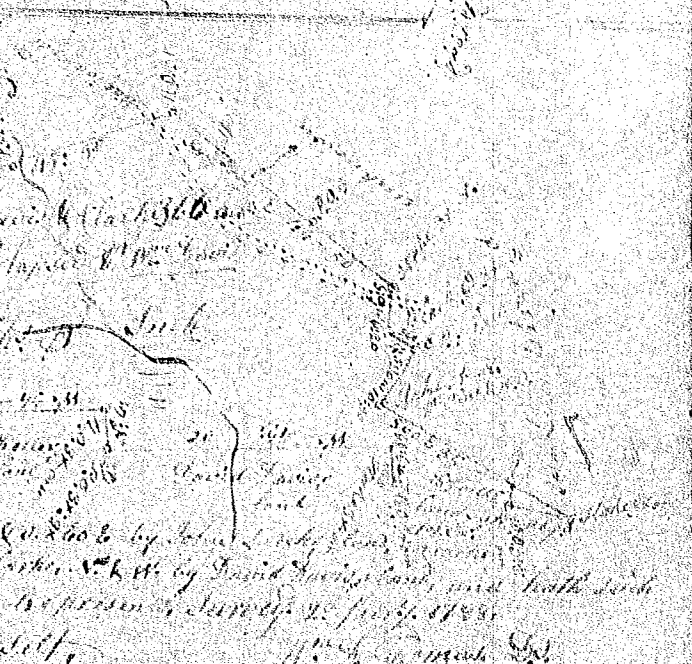



 

Recorded 10th Nov 1788
 Geo. H. Butler

