



South Carolina Pursuant to a warrant from (63)  
 John Thomas Esq. Comr. of Locations & Grants, Palmetto  
 Dated 2<sup>d</sup> Nov. 1788, I have admeasured & laid  
 out unto John Strange a Tract of six hundred  
 acres of land, on the waters of Pacolat  
 River & Thicket Creek, bounding by a  
 line S. E. N. E. & W. by land survey for  
 John M. whorter, S. E. S. W. & W. by  
 land survey for Joseph Gault, S. E. by  
 land survey for Elener M. whorter,  
 S. E. by land survey for Schmiedeman  
 N. W. N. E. & S. E. by land survey for  
 John Strange, all other sides on  
 vacant Land, and hath such shape  
 and Marks as the above Plat represents.  
 Survey 5<sup>th</sup> Dec. 1788. 11<sup>th</sup> Eastern  
 Recorded 8<sup>th</sup> Jan. 1789. Del. Greenhorn

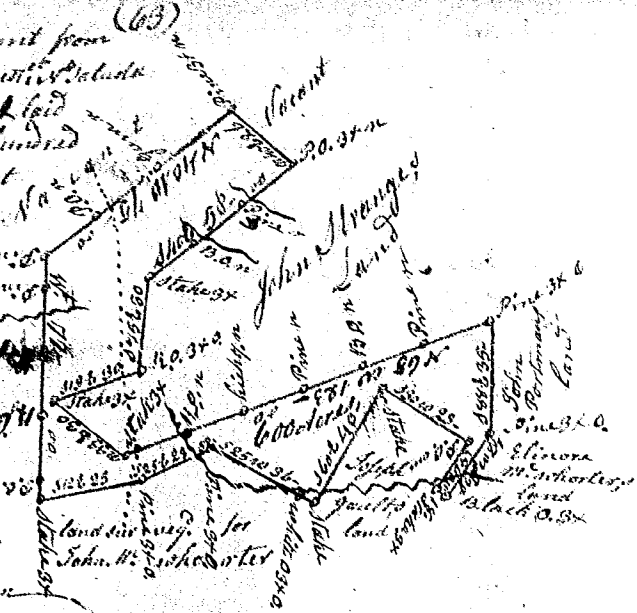

South Carolina Pursuant to  
 a warrant from John Thomas  
 Comr. of locs Dated 9<sup>th</sup> Oct. 1788  
 I have admeasured & laid out  
 unto James Hawkins a tract of  
 228 acres of land on bogans  
 Creek of Sugar river — Boun-  
 dary by lines running S. E.  
 on Ashford's land of Job Hogins  
 & land laid out for Job Hogins,  
 by a line N. E. on Robert Williams  
 land, by a line S. E. on Jacob  
 Hulingsworth's land, & on Jacob  
 Hulingsworth's land  
 and hath such shape and Marks as the above Plat represents  
 Recorded 8<sup>th</sup> Jan. 1789. Survey 3<sup>rd</sup> Nov. 1788. Del. Greenhorn

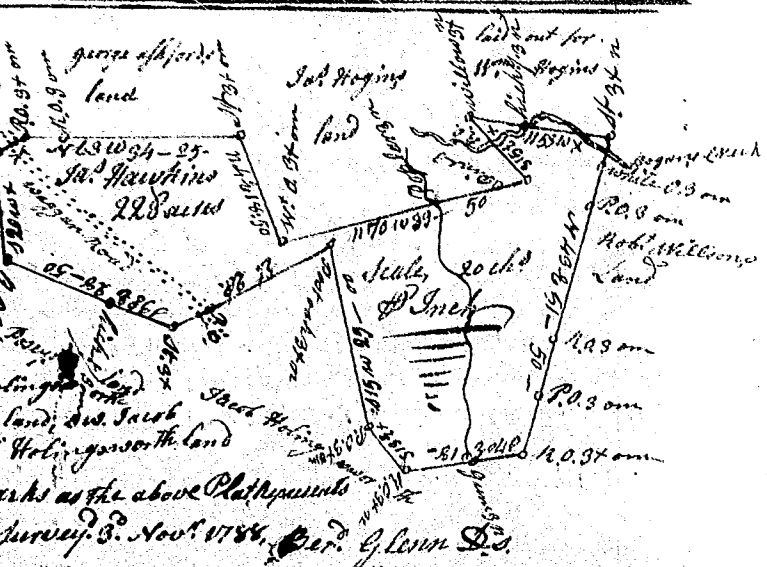

South Carolina Pursuant to a warrant  
 from John Thomas Esq. Comr. of locs Dated  
 9<sup>th</sup> Oct. 1788, I have admeasured and laid  
 out unto James Hawkins a tract of 214 acres  
 of land, on the branches of Cain Creek of  
 Sugar river, Bounded by a line  
 running N. W. Eli Cook's land & James  
 Hawkins, land, a line running S. E. on  
 William Hulingsworth & David Hopkins land  
 by line N. E. W. Hulingsworth's land, S. W. by land  
 of David Hopkins & Thomas Shockley, and hath  
 shape and Marks as the above Plat represents  
 Recorded 8<sup>th</sup> Jan. 1789. Survey 23<sup>rd</sup> Oct. 1788  
 Del. Straun Ben. Glenn Esq.

