



Robt Hanna Esq.
Recorded the 27th Sept^r 1790 Sent to Robt Hanna

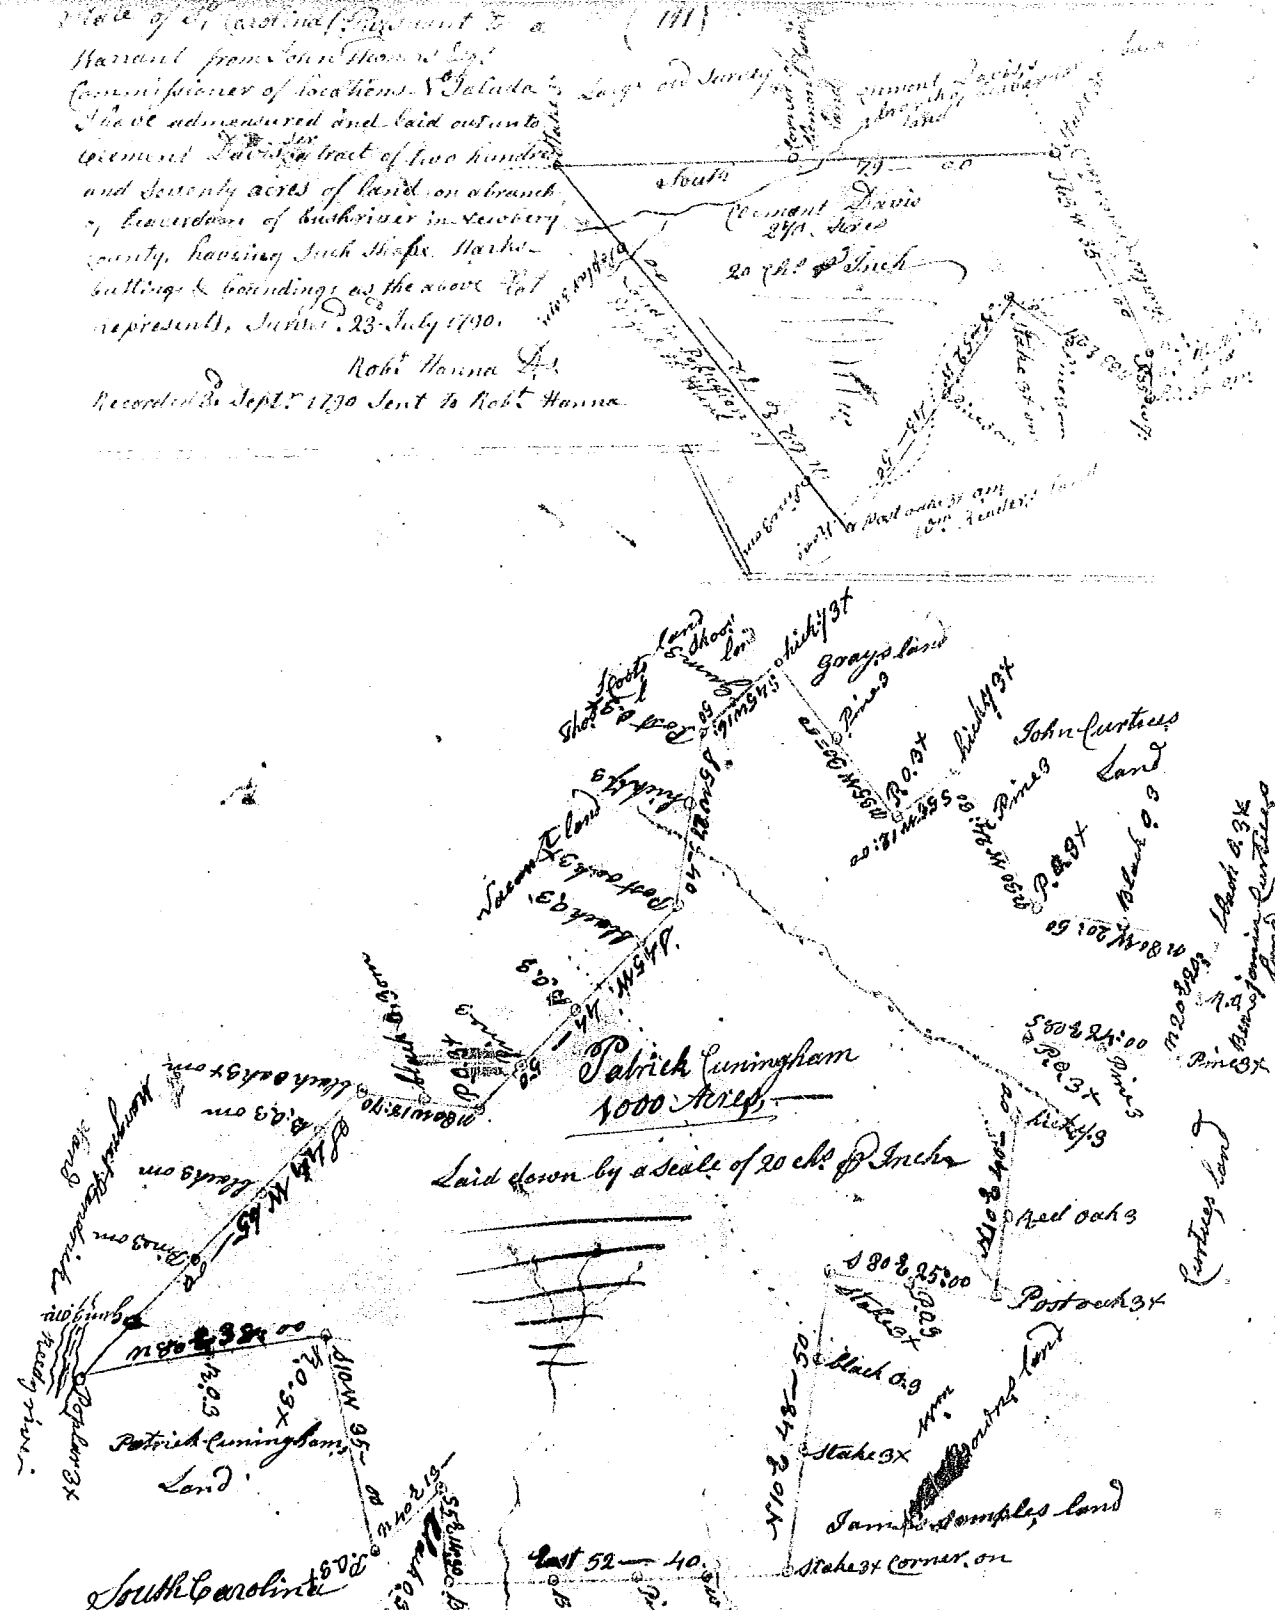

Pursuant to a warrant Patrick Cunningham's land from John Thomas Esq. Com^r of locations 96th District N^o Saluda ^{the} 27th Oct^r 1790. I have admeasured and laid out unto Patrick Cunningham a tract of one Thousand acres of land, on the waters of Saluda & Sandy rivers in Lawrence County & in Ninety six district, and hath such shap, boundaries & shape form and Marks as the above Plat doth represent.

Certified for the 20th Aug^t 1790, David Cunningham Esq.
Recorded the 27th Sept^r 1790 Del. his son