


State Carolina

by the Pacolet River & Islands to the N. E. Corner of the tract bounded on the S. E. by Hendersons & on the S. W. by the front works & by Joseph Lewis Land W. by John Hammitts Land N. by John Hammitts Land

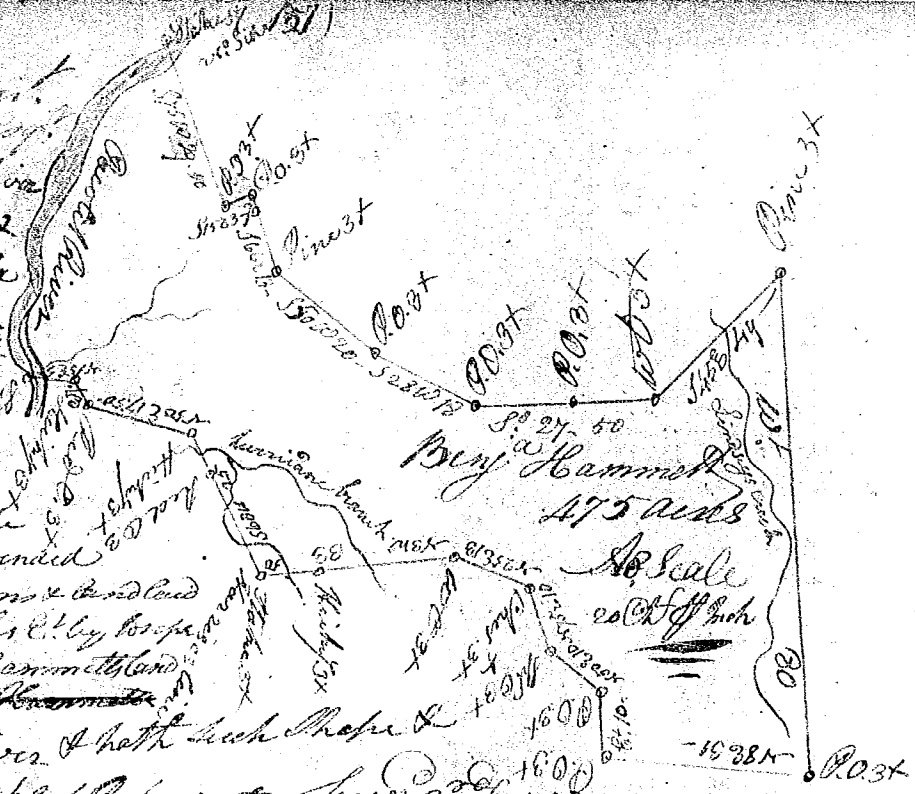

Recorded the 15th Oct. 1791 - Sur. the 3rd Sept. 1791 - Vandyke M. Beech

Pursuant to a warrant from John Thomas Esq. of Saluda. I have measured & laid out unto John Hammitt a tract of 206 acres of land situated in 96 Sect. Harton on the N. side of Pacolet River bounded E. by Hammitts Land W. by the Dutch Settlement the other side vacant & both sides with stakes & marks as the above plat represents



Recorded the 15th Oct. 1791 - Sur. the 3rd Sept. 1791 - Vandyke M. Beech

Pursuant to a warrant from John Thomas Esq. Commander in 96 Sect. Harton of Saluda dated the 15th April 1791 I have measured & laid out unto Jonas Dawson a tract of two hundred & fifty six acres of land situated in the district of Carolina between the middle river in Greenville County bounding E. by the line between John Thomas & Thomas S. Jones Dawson all other sides vacant & both sides with stakes & marks as the above plat represents



Surveyed the 16th April 1791 - J. D. Thomas Esq. Recorded the 25th Oct. 1791