



South Carolina, Pursuant to a warrant from John Thomas Esq. Comr. of locations dated the 10th day of Feb^r 1799 I have admeasured and laid out unto Baylis Earle Trist's tract wood of land containing two hundred & fourteen acres situate lying & being in the District, Spartanburg-County on both sides of the Beaver-dam Creek of South Pacolat River and wood-branch of 5th Pacolat River bounded on Simmons land, by a line running thence S 39 E 80 chains, by John Lewis's land, by a line running N 66 W 14 ch^s thence N 14 E 14 = 50, all other sides on vacant land, and hath such shape form & marks as the above Plat represents. Survey: 10th Feb^r 1799. W.D. Thomas Esq. Recorded 19th Feb^r 1799.

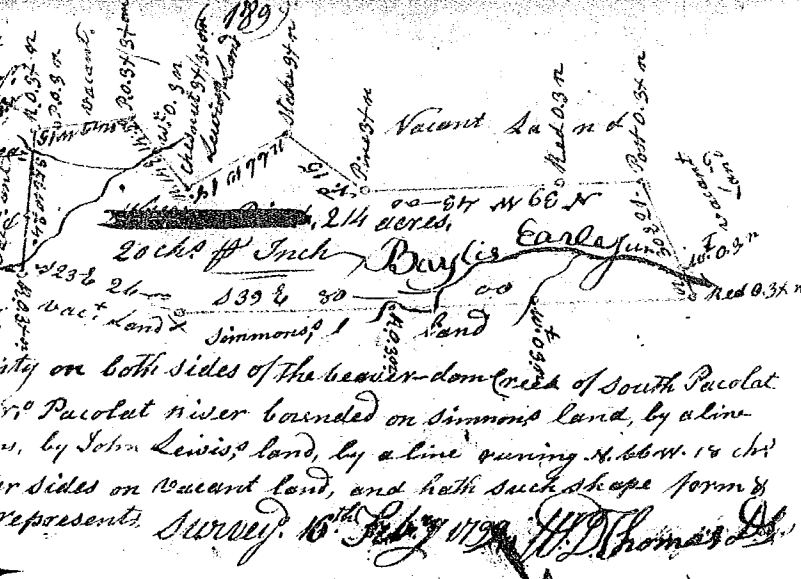

South Carolina, Pursuant to a warrant from John Thomas Esq. Commissioner of locations of the said river, I have admeasured and laid out unto William Lipscomb Esq. a tract of land containing thirty acres situate in 3^d District, in gachery creek a branch of Thickety Creek, waters of Broad River, bounded on the N by Jones land NW by Simmons land N by Lipscomb's land E by John Simons land and hath such shape quantity & marks as the above Plat represents. Survey: 29th March 1792. J. Smith Esq. Recorded 1st May 1792.



South Carolina, Pursuant to a warrant from John Thomas Esq. Comr. of locations dated the 23rd April 1792. I have admeasured & laid out unto John Hunt a tract of three hundred & sixty acres of land situate in Greenville County on both sides of Broad Creek of Broad River. Bounded by Jones land N on John Hunt's land S.E. on Simmons land N.E. on land of John Hunt & N.W. on John Varnal's land & hath such shape & marks as the above plat represents. Survey: 24th April 1792. J. Smith Esq. Recorded the 9th day of May 1792. J. Smith Esq.

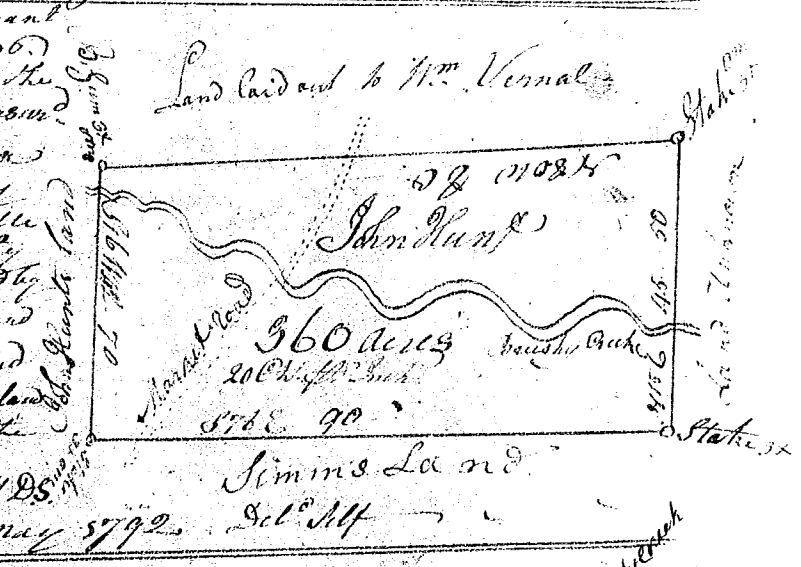

State of S. Carolina Pursuant to a warrant from John Thomas Comr. of locations of Saluda I have measured and laid out unto Wm. Wilkins one hundred and eighty five acres of land bounded N. by Wm. Wilkins land S. by Josiah Simmons N.E. by Wm. Lipscomb's land and hath such shape form and marks as the above Plat represents. Survey: 28th April 1792. Nardog M. Bee Esq. Recorded 1st May 1792. D. L. son

