


So Carolina, Pursuant to a warrant from


(270)

John Thomas Esq. Col. in the District of Washington dated the 24th Oct. 1793. I have admeasured & laid out unto Thomas Farrar a tract of 1000 acres of land situated in the District on the head branches of York Creek of the North of Cal. das River; N.W. & N.E. by Thomas Farrar's land

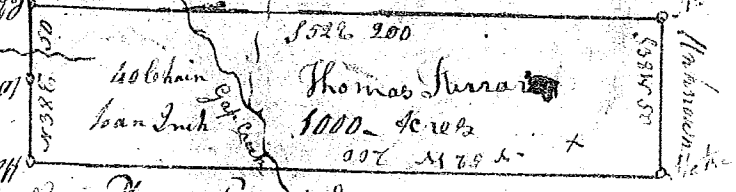


Recorded the 8th Nov. 1793


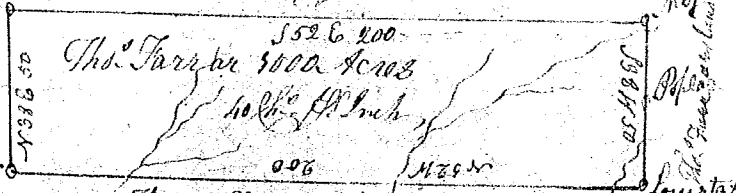




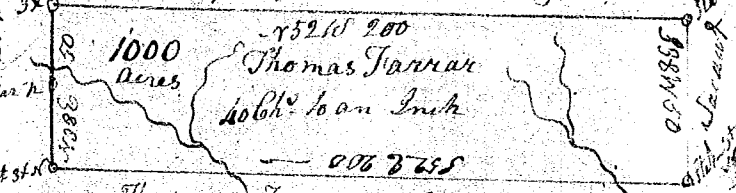




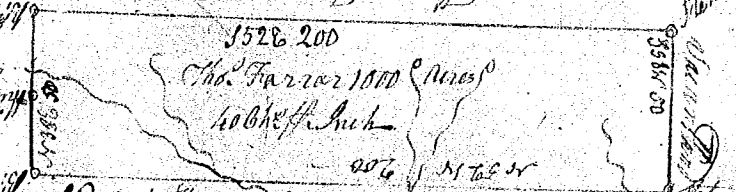




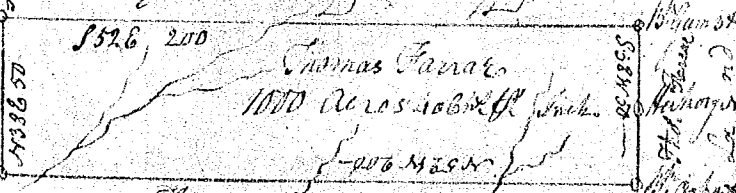



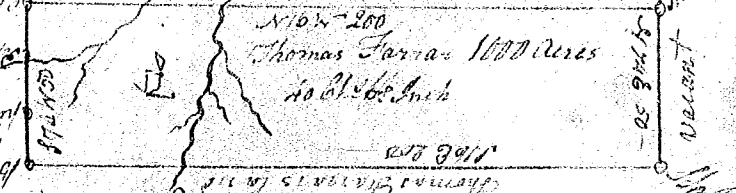

Recorded the 30th Oct. 1793

Recorded the 8th Nov. 1793