




273
 S. Carolina Pursuant to a warrant from John Thomas Esq. C. C. of Salisbury dated the 21st Nov. 1793 I have admeasured & laid out into Robert Middleton a tract of One thousand acres of land situated in Greenville County on a branch of Saluda River bounded N. W. E. & S. E. by the said Robert Middleton's land 488 1/2 ft. long & hath such shape & marks as the above plat represents Certified the 2nd Nov. 1793
 Recorded the 9th Nov. 1793 James Pitt Deput.

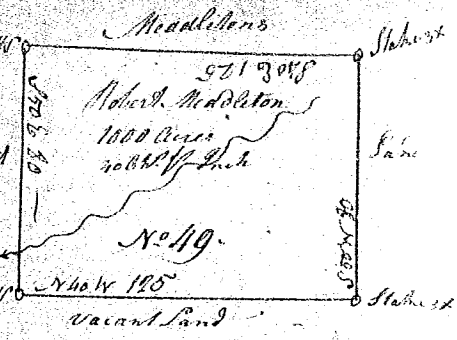


S. Carolina Pursuant to a warrant from John Thomas Esq. C. C. I have admeasured & laid out into Robert Middleton a tract of One thousand acres of land situated in Greenville County on a branch of Saluda River bounded on all sides by the said Robert Middleton's land & hath such form & marks as the above plat represents Certified the 2nd Nov. 1793 James Pitt Deput.
 Recorded the 9th Nov. 1793

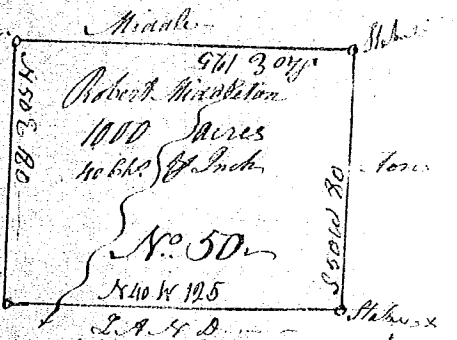


S. Carolina Pursuant to a warrant from John Thomas Esq. C. C. I have admeasured & laid out into Robert Middleton a tract of 1000 acres of land situated in Greenville County on a branch of Saluda River bounded on all sides by the said Robert Middleton's land & hath such form & marks as the above plat represents Certified the 2nd Nov. 1793
 Recorded the 9th Nov. 1793

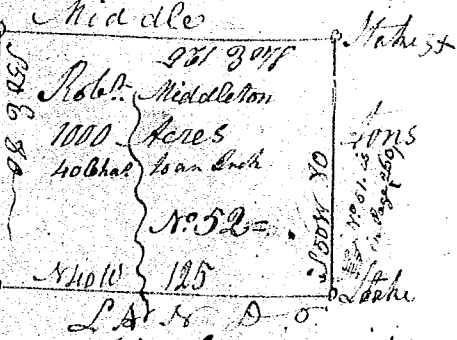

S. Carolina Pursuant to a warrant from John Thomas Esq. C. C. I have admeasured & laid out into Robert Middleton a tract of One thousand acres of land situated in Greenville County on a branch of Saluda River bounded on all sides by Robert Middleton's land and hath such shape & marks as the above plat represents Certified the 2nd Nov. 1793 James Pitt Deput.
 Recorded the 9th Nov. 1793

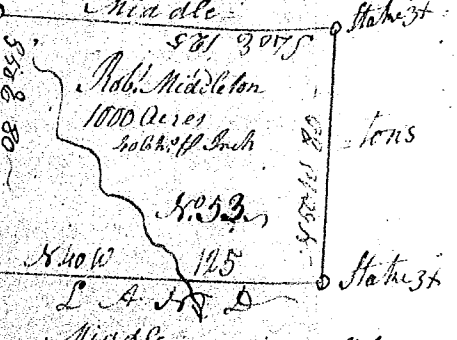

S. Carolina Pursuant to a warrant from John Thomas Esq. C. C. I have admeasured & laid out into Robert Middleton a tract of One thousand acres of land situated in Greenville County on a branch of Saluda River bounded on all sides by the said Robert Middleton's land & hath such shape & marks as the above plat represents Certified the 2nd Nov. 1793 James Pitt Deput.
 Recorded the 9th Nov. 1793

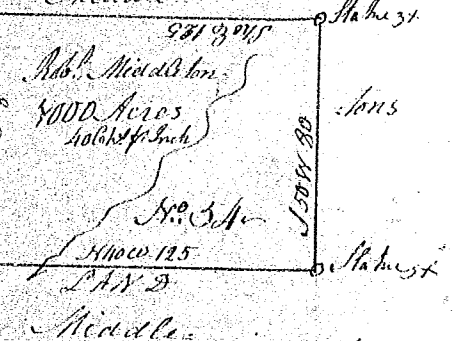

S. Carolina Pursuant to a warrant from John Thomas Esq. C. C. I have admeasured & laid out into Robert Middleton a tract of One thousand acres of land situated in Greenville County on a branch of Saluda River bounded on all sides by Robert Middleton's land and hath such shape & marks as the above plat represents Certified the 2nd Nov. 1793 James Pitt Deput.
 Recorded the 9th Nov. 1793

