



Marolina Pursuant to  
a warrant from John  
Thomas Esq. Com. for the  
Shave said out to Charles  
D. Bradford a tract of  
land containing One  
Thousand acres, Situated  
in Washington District  
Green Hill County on  
waters of Potomac and Sabina  
Rivers. Having such shape  
and marks as the above plat  
represents Certified for this  
20<sup>th</sup> day March 1794  
R. F. Munn D. S. Recorded 29<sup>th</sup> Sept<sup>r</sup> 1794

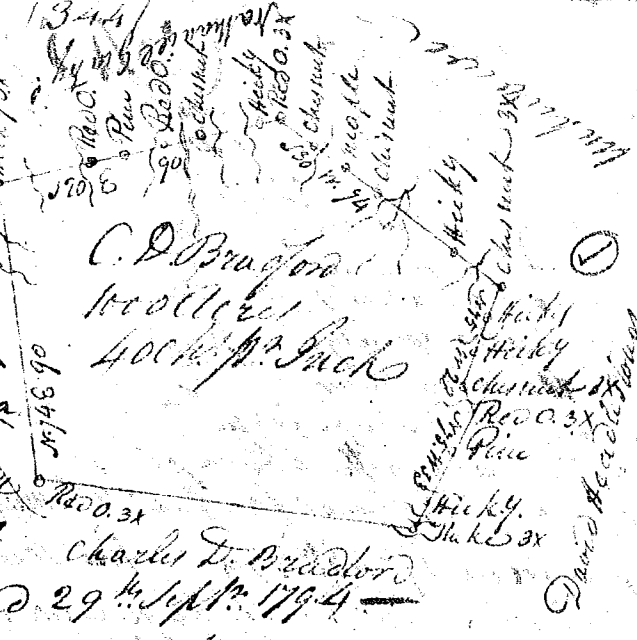

Marolina Pursuant to a warrant  
from John Thomas Esq. Com. for the  
Shave said out to Charles  
D. Bradford a tract of land containing  
One Thousand acres  
Situated in Dist of Washington  
& Green Hill County on the  
waters Potomac River & Sabina  
River. Having such shape  
& marks as the above plat  
represents Certified for this 24<sup>th</sup> March 1794  
Recorded 29<sup>th</sup> Sept<sup>r</sup> 1794



Marolina Pursuant to a  
warrant from John  
Thomas Esq. Com.  
Location. Shave  
said out to Charles  
D. Bradford a tract  
of One Thousand  
acres, Situated in  
Washington Green Hill  
County on the waters of  
Potomac & Sabina Rivers  
having such shape & marks  
as the above plat represents

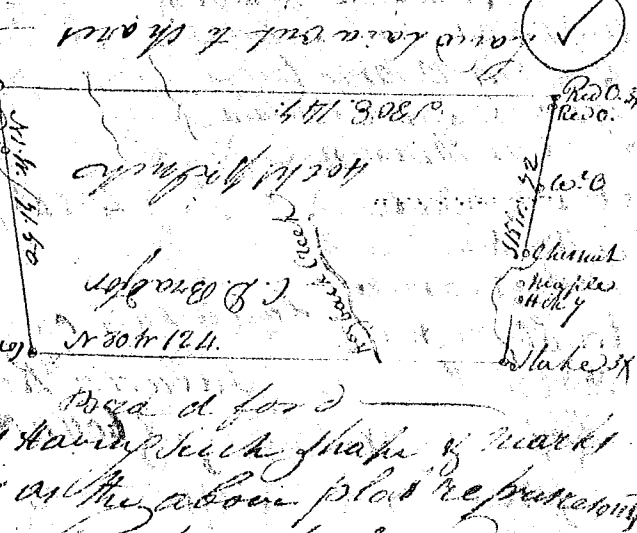

Recorded 29<sup>th</sup> Sept<sup>r</sup> 1794  
Certified for this 22<sup>nd</sup> March 1794  
R. F. Munn D. S.