



Recorded this
29th Sept. 1794

(3A.6)

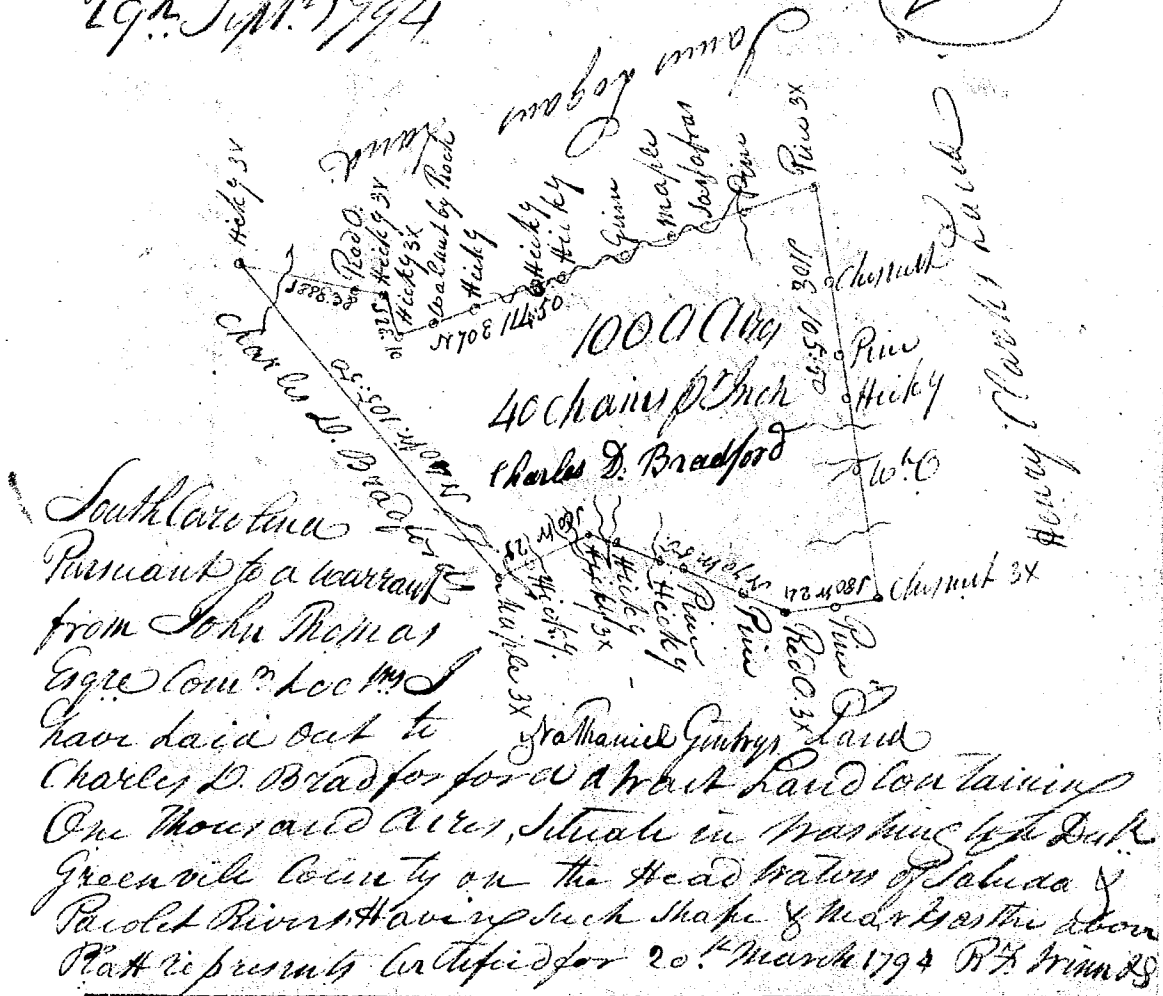

South Carolina
Pursuant to a warrant
from John Thomas Esq
I have laid out to
Charles D. Bradford a tract of land containing
One thousand Acres, Situate in Washington District
Greenville County on the Head waters of Saluda &
Pacolet Rivers Having such shape & measure as the above
Plan represents Certified for 20th March 1794 R. H. Friend

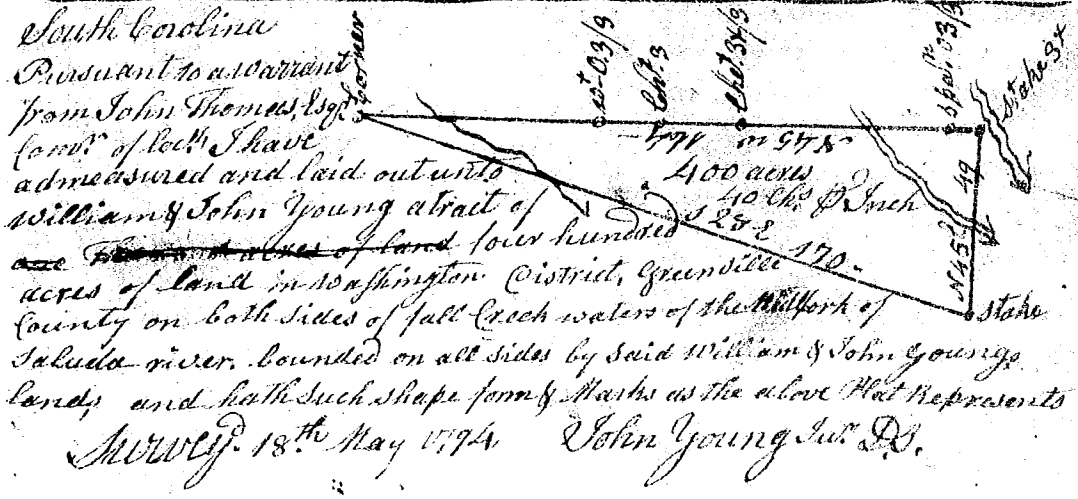

South Carolina
Pursuant to a warrant
from John Thomas Esq
I have
admeasured and laid out unto
William & John Young a tract of
400 acres of land four hundred
acres of land in Washington District, Greenville
County on both sides of full Creek waters of the Millfork of
Saluda river. bounded on all sides by said William & John Youngs
lands and hath such shape form & marks as the above Plan represents
Survey. 18th May 1794 John Young Sur. D.S.

Recorded 8th Oct. 1794 Dec. 1st