


(373) Bent of Tennessee No. 5

Land sold off for Wade Hampton

N 58 W 7130 ch.

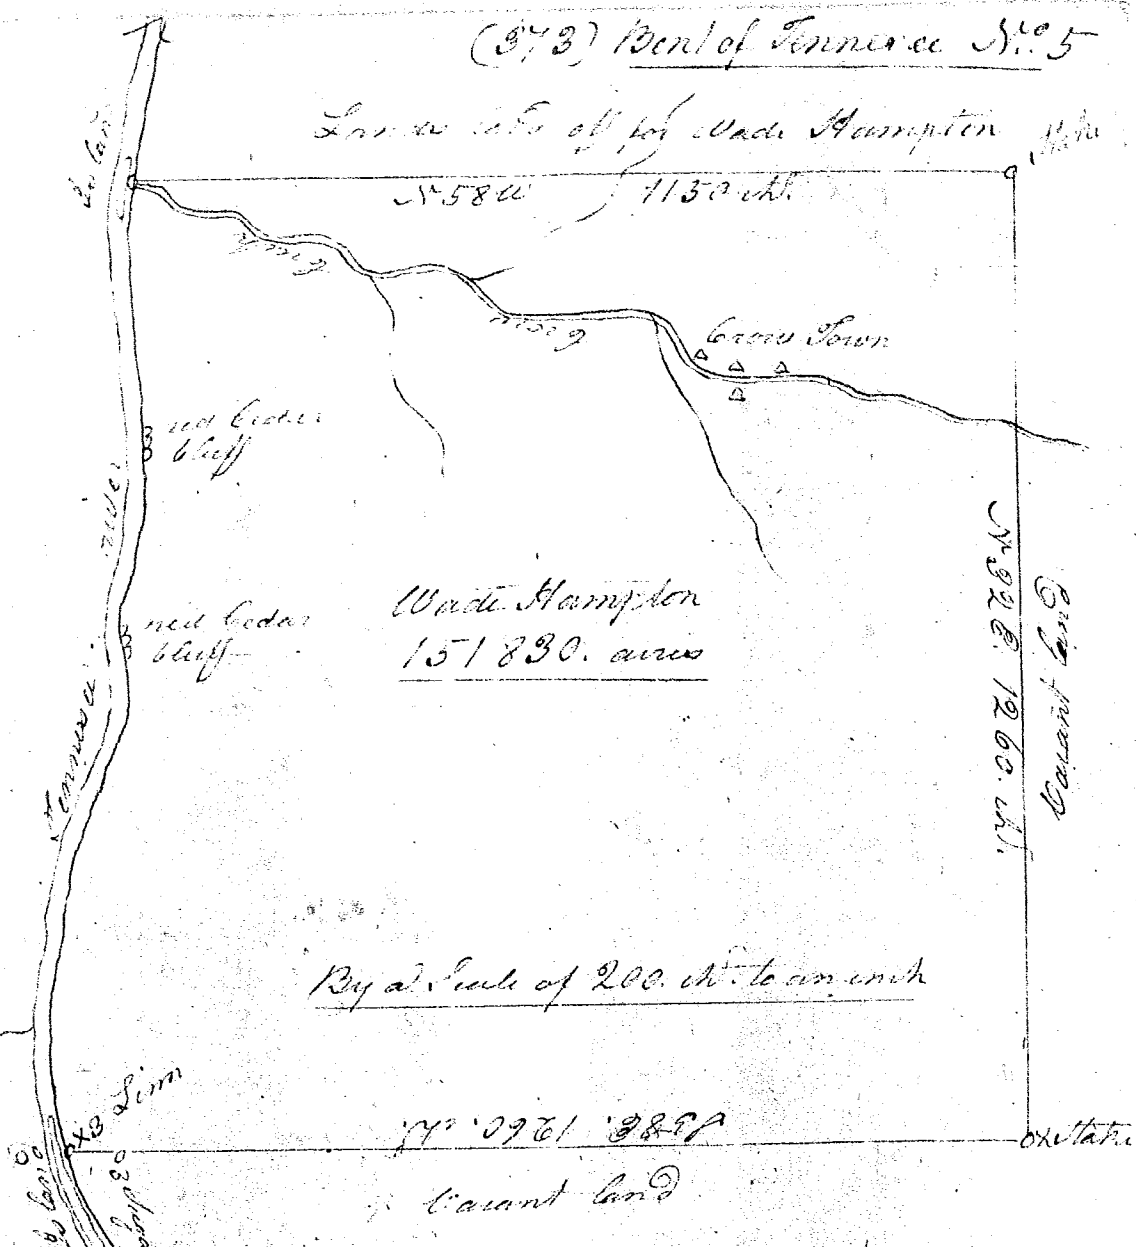

By a Scale of 200. ch. to an inch



State of N. Carolina Pursuant to a warrant from
 District of Sandy Six John Thomas Esq. Com. of locations
 dated the 26th of November 1785 I have laid out for Col.
 Wade Hampton a tract of land lying on the N. Side of Tennessee
 river below the Cumberland mountain adjoining immedi-
 ately above the mouth of Crow creek including the crown
 creek Indian town & such quantity shape marks and
 bounds as the above plat represents Survey'd the 29th of
 December 1785
 Recorded 19th Jan. 1786. by
 J. Smith D. Sur.