


South Carolina

(395)

Pursuant to a warrant from John Thomas Esq. Com. of Surveys North of Saluda river. I have admeasured & laid out unto James Smith, a tract of land lying in Spartanburg County on both sides of Ford's lower creek of Fairforest creek, bounded on the N.W. by Kennon's land on the N.E. by Underwood's land on the S.W. by Connell and Lancaster's land, & on the S.E. by lands survey'd for Hancock Smith. I hath such other marks, bounds, shape, and quantity as the above plat represents.

Survey'd the 22nd July 1797, by

W. Smith Esq. De.
Recorded the 24th Feb^y 1797

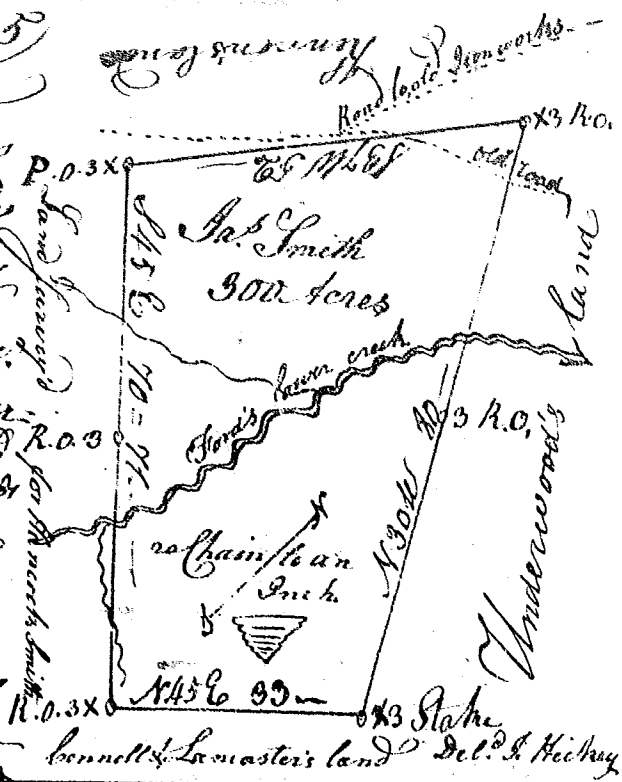

Pursuant to a warrant from John Thomas Esq. Com. of Surveys dated 10th Dec^r 1793. I have admeasured and laid out unto James Huggins a tract of 312 acres of land on both sides of Barton's Creek waters of Pacolat river, bounded on all sides by vacant land, and hath such shape, form & marks as the above plat represents.

Survey'd 7th July 1794,

John Young Esq. De.
Recorded 25th febr^y 1797, De. Mrs. Kagine

