State of South Carolina — (408)

Pursuant to a warrant from John Thomas Esqr. Comr. of locn. N. side Saluda dated 16th June 1797, I have admeasured and laid out unto Joseph Reasonover a tract of 132 acres of land on Yorkway in Greenville County on both sides of a small branch of Armstrongs Creek waters of Saluda river, bounded Sw.ly by land laid out for Mary White N.W.ly by land laid out for David McKay N.E.ly by land surveyd. for Jacob Gardner, S.E.ly by land laid out for Jacob Reasonover, and hath such shape and marks as the above plat represents, — Surveyd. 1st June 1797 —

Recorded 20 June 1797. Del. self George Salmon Ds.

South Carolina / Pursuant to a warrant from John Thomas Esqr. Comr. of locn. N. side of Saluda, dated 10th day of March 1797, I have admeasured and laid out unto John Kelley a tract of four Hundred & sixty five acres of land, situate in Pinkney district Spartanburg County, on small branches of Lawsons forkwaters of Pacolat River, bounded by a line vining S.W. by land surveyd. for Boley Conner, S.E. by land surveyd. for John Conner all other sides by Vacant land, and hath such shape and marks as the above plat represents, Surveyd. 6th June 1797 —

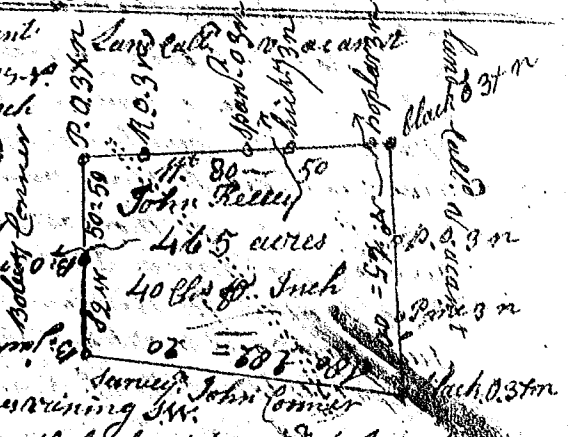

Recorded 8th augt. 1797 Del. self Gabl. Benson Ds.

So. Carolina / By John Thomas Comr. of locn. N. Saluda, dated 21st Septr. 1797 I have admeasured & laid out unto Michael Brown Roberts a tract of fifty three acres of land in Pinkney district Spartanburg County on a branch of Tygar river Rining S.E. with David Andersons land S.W. near or Jayning land Calld. old surveys N.E. & N.W. with Millers land, and hath such shape and marks as the above plat Represents, Surveyd. 7th Novr. 1797, James Wofford Ds.

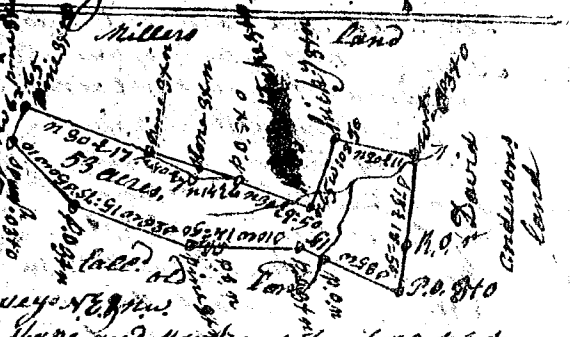

Record 28th Novr. 1797. Del. self