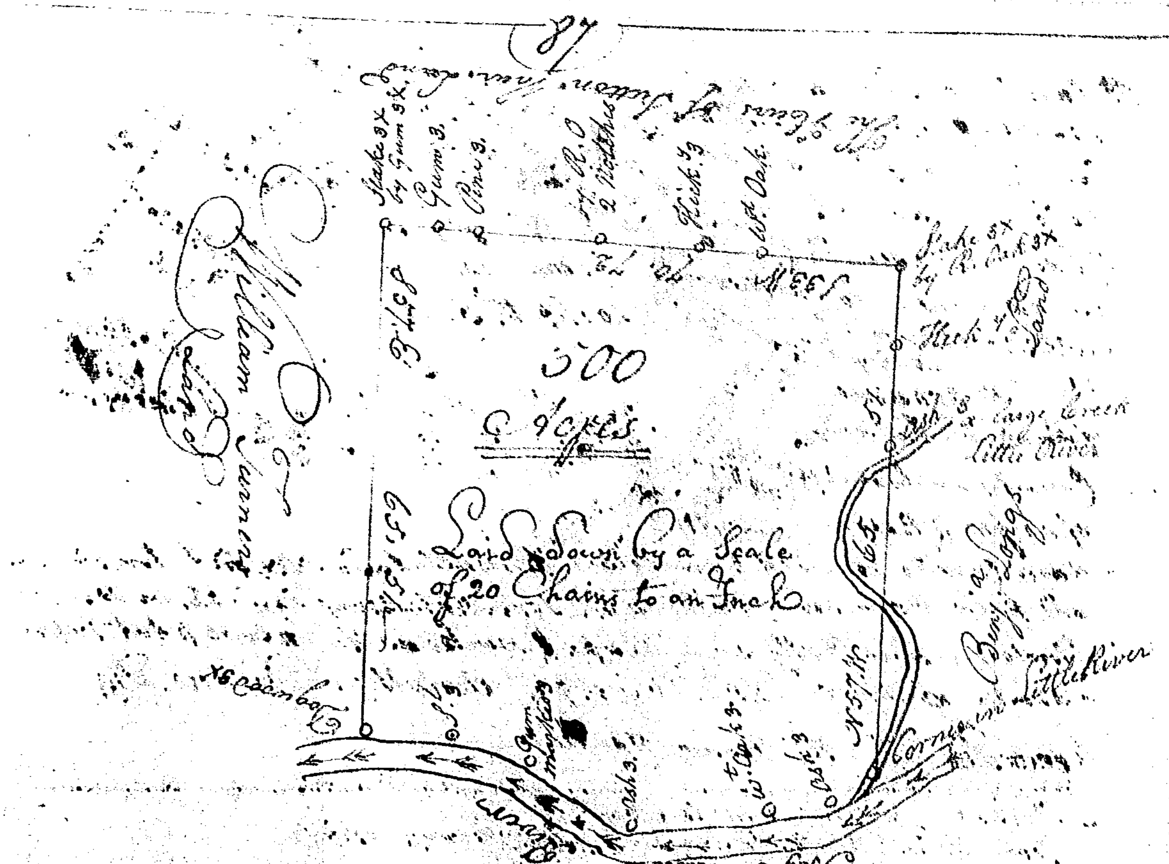

State of South Carolina

Pursuant to a warrant from John Thomas Esqr Comr of Locations for the N. Side of Saluda River bearing date the 17th day of October 1792 I have admeasured & Laid Out unto Daniel Cleary a plantation or Tract of five hundred Acres of Land on the Nd Side of Big Saluda River and hath such Shapes & marks buttings & Boundings as the above plat Represents

Certefyed for the 18th day of Novr 1792

Philemon Waters DS

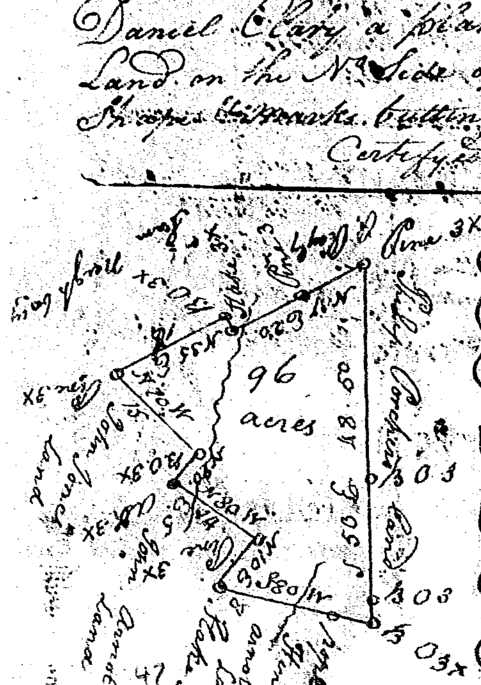

So Carolina

Pursuant to a warrant from John Thomas Esqr Comr of Locations No Saluda dated the 19th Feb. 1793 I have admeasured & laid Out unto John Jones a Tract of Ninety Six acres of Land in Lauren County on the Branches of Horse Creek of Reedy River Bounding So by Philip Porchers land E & S E on Patrick Ryley Saml Neighbours John Jones John and Hendrick Arnolds land & hath such Shape & Marks as the above plat Represents. Surveyed the 23 Feb 1793

Jonathan Downs