


State of S^c Carolina
Pursuant to a warrant
from John Thomas.


Comt. of Loc^s 2^d April
1799. I have adm^{ed}
and laid out unto Eliza

in Greenville County on both sides of
of Mash-Creek waters of S^c Tyger river
and on both sides of the road leading from Greenville
Court house to Green River road bounded S.W.^{ly} by land laid out for William
Henson by land laid out for Denis Duff & by vacant land N.E.^{ly} by land laid
out for John Nicol S.E.^{ly} by land laid out for James Nicol by land laid out
for William Cole & by land laid out for George Salmon and hath such
shape & marks as the above plat represents, Survey 2^d April 1799,
recorded 5th Sept^r 1799. George Salmon S^c.

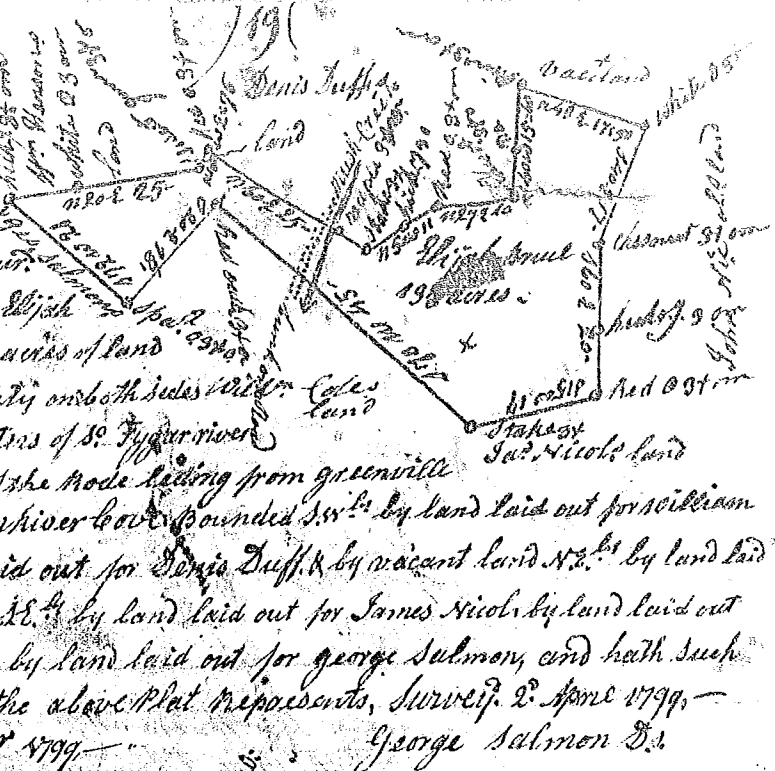

South Carolina Pursuant to a
warrant from John Thomas.

Comt. of Loc^s & S^c Saluda
dated 2^d Sept^r 1799. I have ad-
-measured and laid out unto
Jacob Barrett a tract of nine acres & three fourths
in Newberry County on a branch of Beaverdam Creek
water of Saluda river bounded by a line running S.W. by
land of James Barrett N.E. by land of James Johnston S.E. by
land of John Marput, and hath such shape form and
marks as the above plat represents, Survey 6th Sept^r 1799,
Recorded 14th Sept^r 1799. P. B. Waters S^c.

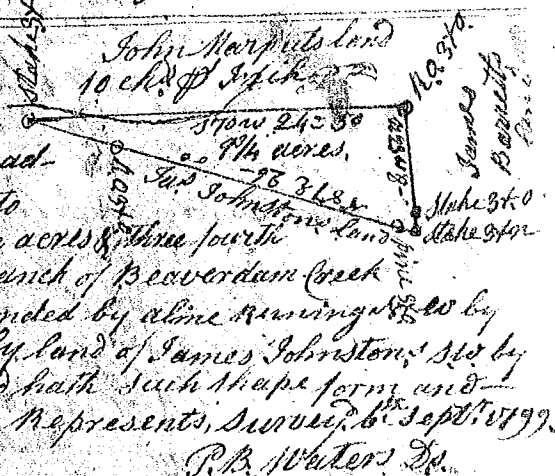

South Carolina

Pursuant to a warrant
from John Thomas
Comt. of Saluda
dated the 4th Sept^r
1799. I have adm^{ed}
& laid out unto J^o
Pugh a tract of 30
acres of land, situate
in Newberry County on a little creek of Saluda River. Bounded
by a line running N.W. by David Pugh & Burtunsel's. S.W. Charles
Lester & J^o Pugh, S.E. by Luke Smith & hath such form
and marks as the above plat represents, Survey 4th Sept^r 1799

Recorded the 13th Sept^r 1799. P. B. Waters S^c.

