


S. Carolina

32

Pursuant to a Warrant from
 Wm. D. Thomas Esq. C. S. dated the 1st July
 1805. I have admeasured & laid out unto
 acres of land, situate lying & being in
 Greenville District, on both sides of
 Townes mill creek, the waters of Saluda
 river, bounded to the S.E. by Tho. Casleys land
 to the N.E. on said Sam. Townes's land
 to the W. by Wm. Townes's land. & hath such shape form & marks as
 the above plat represents, Wm. D. the 5th July 1805

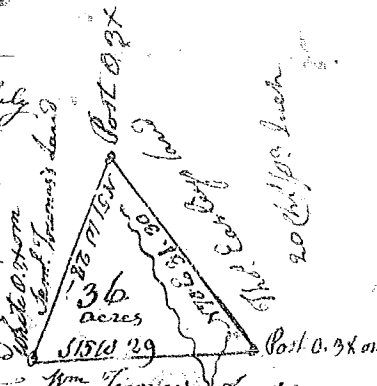

Recorded 27th Sept. 1805 John Young Sur. D. Dep. S. C.

South Carolina

Pursuant to a Warrant
 from Wm. D. Thomas Com.
 of Locations in Greenville
 District Dated the 12th Aug.
 1805. I have admeasured
 & laid out unto William
 Capps a tract of land
 containing two Hundred
 & Eight acres, situate
 in the said District, on
 both sides of Merritts
 mill-creek, waters of
 the North fork of Saluda
 river. Bounded by lines
 running S.W. by N. & S.E. by Benjamin Merritts Land
 N.W. by Francis Covertens land, & on all other sides
 by vacant land. & hath such shape form & marks as
 the above plat represents.



Surveyed the 12th day of August 1805

Recorded the 29th Oct. 1805 W. H. Coates D. Sur.