


Chas Bearers  
James Cantrell  
David Cantrell

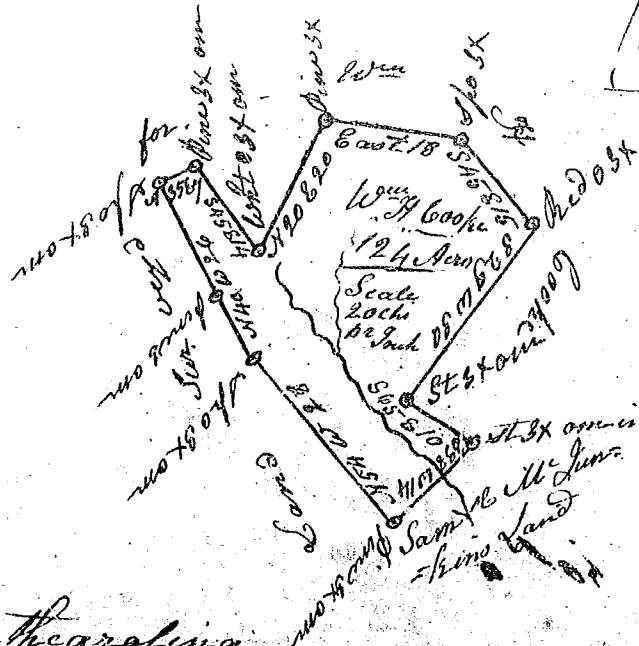

South Carolina

Pursuant to a Warrant from W<sup>m</sup> Thomas  
 Commissioner of Locations in the District  
 of Greenville Dated the 22<sup>nd</sup> Day of January  
 1815, I have admeasured & laid out  
 unto William Henry Cooke a Tract of Land  
 containing one hundred & Twenty four  
 Acres, Situate in said District on both  
 Sides & including the head of a branch  
 of Burleighs Creek waters of the middle  
 fork of Saluda River, Bounded by a line  
 Running S 85 1/2 W 1/2 mi by Samuel M<sup>r</sup> Jenkins Land  
 & on all other Sides by W<sup>m</sup> H Cooke's Land  
 and hath such form & marks as the above  
 Plat Represents  
 Surveyed the 5<sup>th</sup> Day of March 1815  
 Recorded the 5<sup>th</sup> Day of August 1814  
 W<sup>m</sup> H Cooke