

South Carolina Pursuant to a warrant from John Thomas Esq. Comr. of locs. (dated 1st Aug 1801) I have admeasured & laid out unto Joseph Sullivan a tract of two hundred & thirty two acres of land in Spartanburgh District on Bullocks fork of the Chety Cree waters of Broad River bounded N. by Greater Buices and Halls land W. by Hugh Moore and Lepscombs lands S. by Dixons land E. by William Thomsons land and Halls such farms, Maips as the above plat represents

Survey 8th Aug 1801

Rich. Thompson D.S.

Recorded 14th Aug 1801




South Carolina Pursuant to a warrant from John Thomas Comr. of locs. of side taken dated 1st Aug 1801 I have admeasured & laid out unto Joseph Bell a tract of 17 acres of land in Spartanburgh District on Cherokee creek of Broad River bounded S. by Nath. Robertson land E. by Charles Haslers land & W. by said Joseph Bell's own land and hath such shape & marks as the above plat represents

Survey 8th Aug 1801

Rich. Thompson D.S.

Recorded 14th Aug 1801

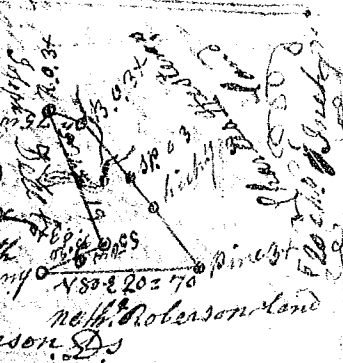

South Carolina Pursuant to a warrant from John Thomas Esq. I have admeasured and laid out unto Jonathan Buice a tract of 112 acres of land, in Spartanburgh District on Bullocks fork of the Chety Cree of Broad River bounded S. by William Buices land N. by Elias Smith land W. by Jonathan Harris land and hath such form & marks as the above plat represents

Survey 8th Aug 1801

Recorded 14th Aug 1801



Richard Thompson D.S.