


South Carolina Pursuant to a warrant from John Thomas, Comr. of So. Carolina I have measured and laid out unto Joseph Lively a tract of three hundred & seventy acres of land in Spartanburgh District on the N. side of Pacolet River of broad river about half a mile from Hammel's ford on branches of said river, bounded S. by Pools land, E. by Griffins land N. by unknown land, W. by Brittan George & Lively's lands, and hath such shape & marks as the above plat represents, Surveyed 16<sup>th</sup> Sept. 1802 by Rich<sup>d</sup>. Thomson Esq.

Recorded 18<sup>th</sup> Sept. 1802,

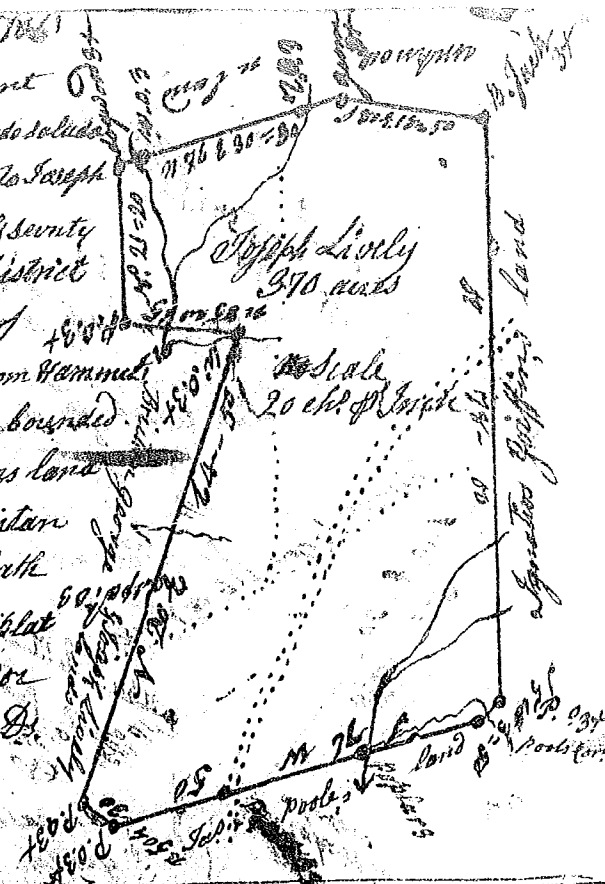

Note: This plot was recorded here, on 19<sup>th</sup> Sept. 1802.


South Carolina Pursuant to a Warrant from John Thomas Esq. C. L. dated the 15<sup>th</sup> March 1802 I have measured & laid out unto John Mearns a tract of Fifty Acres of land Situate in Spartanburgh District on the Middle fork of Tyger River Bounded by lines Running S. by Vanderhorst's land & E. unknown N.W. by Henry Gray's & W. Hills Land & S.W. by Smith's Land & hath such form & marks as the above plat represents. Surveyed the 20<sup>th</sup> March 1802

Recorded the 20<sup>th</sup> March 1802



South Carolina Pursuant to a warrant from John Thomas Comr. of So. Carolina dated 14 Sept. 1801 I have measured and laid out unto James Crow a tract of 25 acres of land in Spartanburgh District on branches of Tyger River, running with lines N. by W. E. with James Crow, S. with Wilson's land S.E. Robert Rogers N.E. Jacob Linnist's land and hath such shape as the above plat represents

Recorded 29<sup>th</sup> Sept. 1801

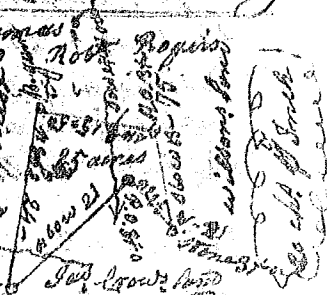

Surveyed 19<sup>th</sup> Sept. 1801 Filed w<sup>o</sup>fford Esq.