


Closed by Thomas Bowers

Pursuant to agreement from John Thomas Court of Cook N. side dated 24th Sept. 1801, I have admeasured and laid out unto Charles Gawnel a tract of one hundred & twenty one acres of land in greenville district on both sides of Morgans creek of the Birch hole part of Sugar River bounded generally by land out for Jonas Dawson, &c. other sides vacant land and hath such shapes and marks as the above Plat represents, Surveyed 25th Sept. 1802
 Recorded 24th Dec. 1803
 George Salmon D.

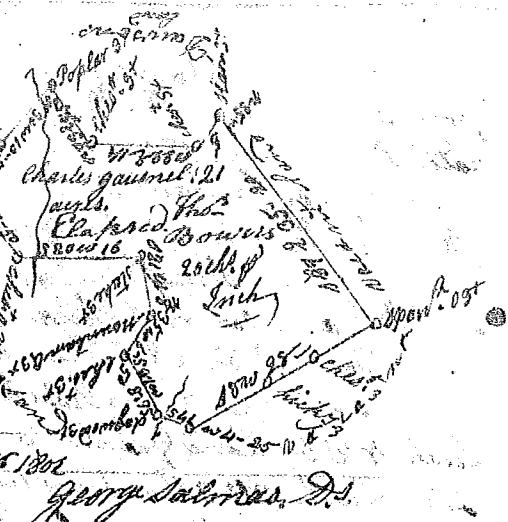

Land laid out for Bob usrey
 N 83 1/2 E. 101 - 00
 Abraham Belw 372 acrs.
 20 Ch. 1/2 Inch

Pursuant to a war - rant from John Thomas Court of Cook N. side Saluda dated 24th Sept. 1801 I have admeasured and laid out unto Abraham Belw a tract of three hundred and seventy two acres of land in green - ville district on the branches of the S fork of Pacolet river, including part of Rich Mountain bounded S. E. by Sophia Gawnel's land & vacant S. W. by Jesse Philips land & John A. Whelan land N. E. by land laid out for Bob usrey & vacant land, and hath such shape and marks as the above plat represents Surveyed 25th Sept. 1802
 Recorded 24th Dec. 1802
 George Salmon D.

Pursuant to agreement from John Thomas Court of Cook N. side dated 19th Dec. 1801 I have admeasured & laid out unto Robert Colman a tract of seventy two acres of land in Union district near the S side of Pacolet river bounded S. E. & S. on Hendersons land & vacant S. W. by John gibson land N. E. by John Hames land N. W. by John Coleman & Robert Colman's land and hath shape & marks as the above Plat represents Surveyed 24th Dec. 1801
 Recorded 26th Dec. 1801
 Robert Thomson D.

