

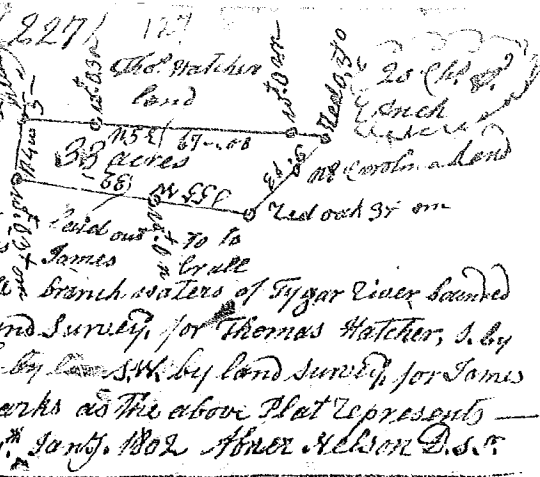


227 127  
 South Carolina Pursuant to a warrant from John Thomas Comr of locs N side Saluda dated 11<sup>th</sup> Jan<sup>y</sup> 1802, I have admeasured and laid out unto Johnson Ferguson a tract of Thirty Three acres of land in newberry District on a small branch waters of Sygar River bounded by lines running N 45° E. by land Survey for Thomas Hatcher, S. by a North Carolina Tract of land by land survey for James Crall, and both such shape & marks as the above Plat represents — recorded 16<sup>th</sup> Jan<sup>y</sup> 1802 Survey 14<sup>th</sup> Jan<sup>y</sup> 1802 Abner Nelson D.S.

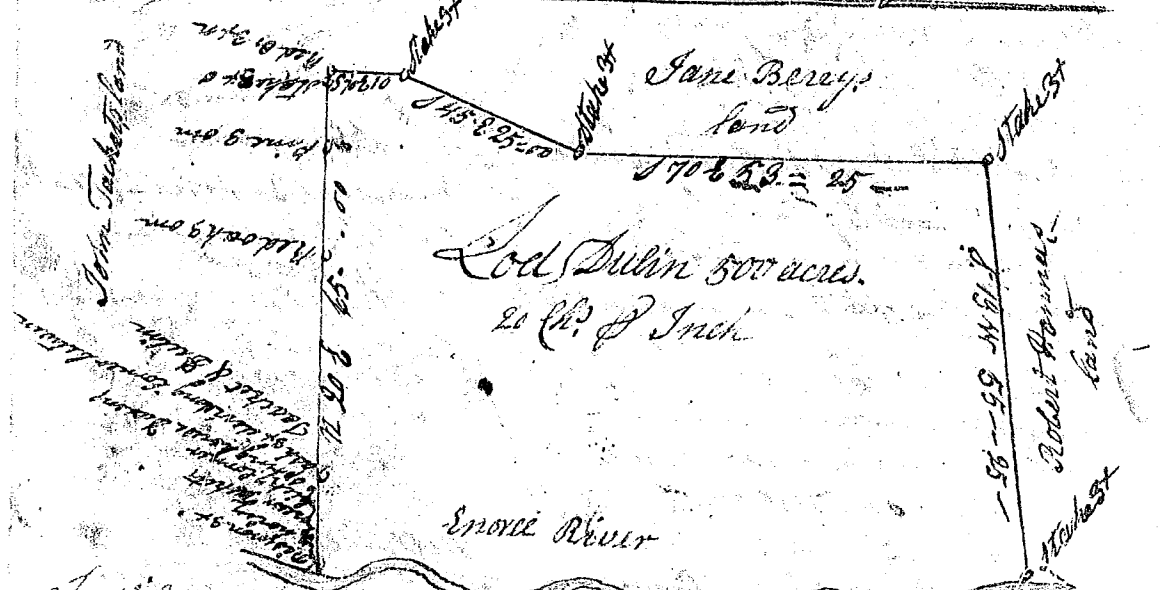



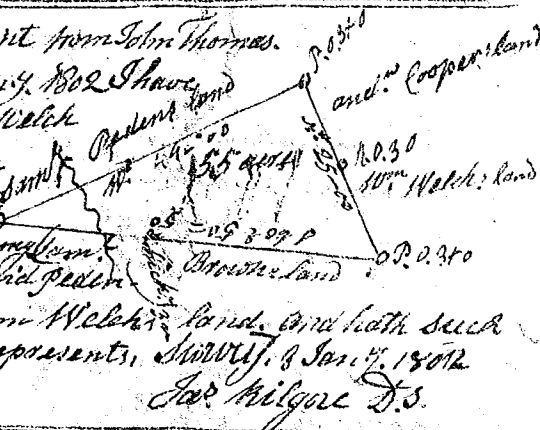

