


 Martin Adams bears
 Scale 20 Ch. 10" Inch

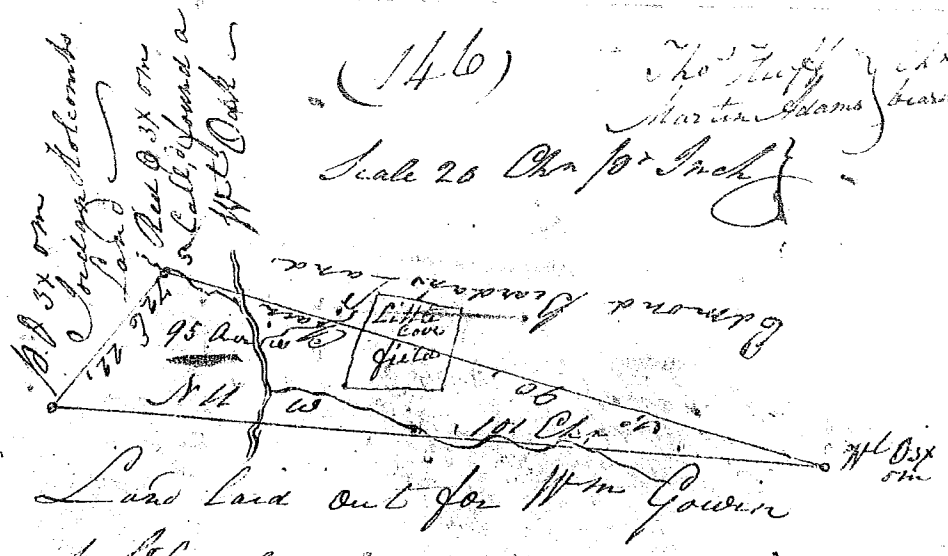

Land laid out for Wm Gowin

State of S. Carolina
 Greenville District Pursuant to a warrant from
 John Young Esquire Commissioner of Locations for
 the District aforesaid, applicable to this warrant dated
 the 30th of March 1818, I have admeasured & laid out
 unto Francis Adams a tract of Land containing
 ninety-five Aers, situate in the said district, on
 both sides of the Middle Fork of Sugar River, bound
 on the East by a line bearing N 74° E by Land laid out for
 Wm Gowin West by Land laid out for Edmund Bear
 dan and East by Jordan's Land, and hath
 such form & Mark as the above Stat. requires
 Dated the 31st day of March 1818,

Willie S. Brown

Recorded the 3rd day of April 1818 by
 John Young C. L.

Delivered to self