


FILED WADE HAMPTON BLVD.  
GREENVILLE, CO. S.C.

FEB 18 2 27 PM '77

DONNIE S. TANKERSLEY  
R.M.C.

~ BOB JONES UNIVERSITY ~

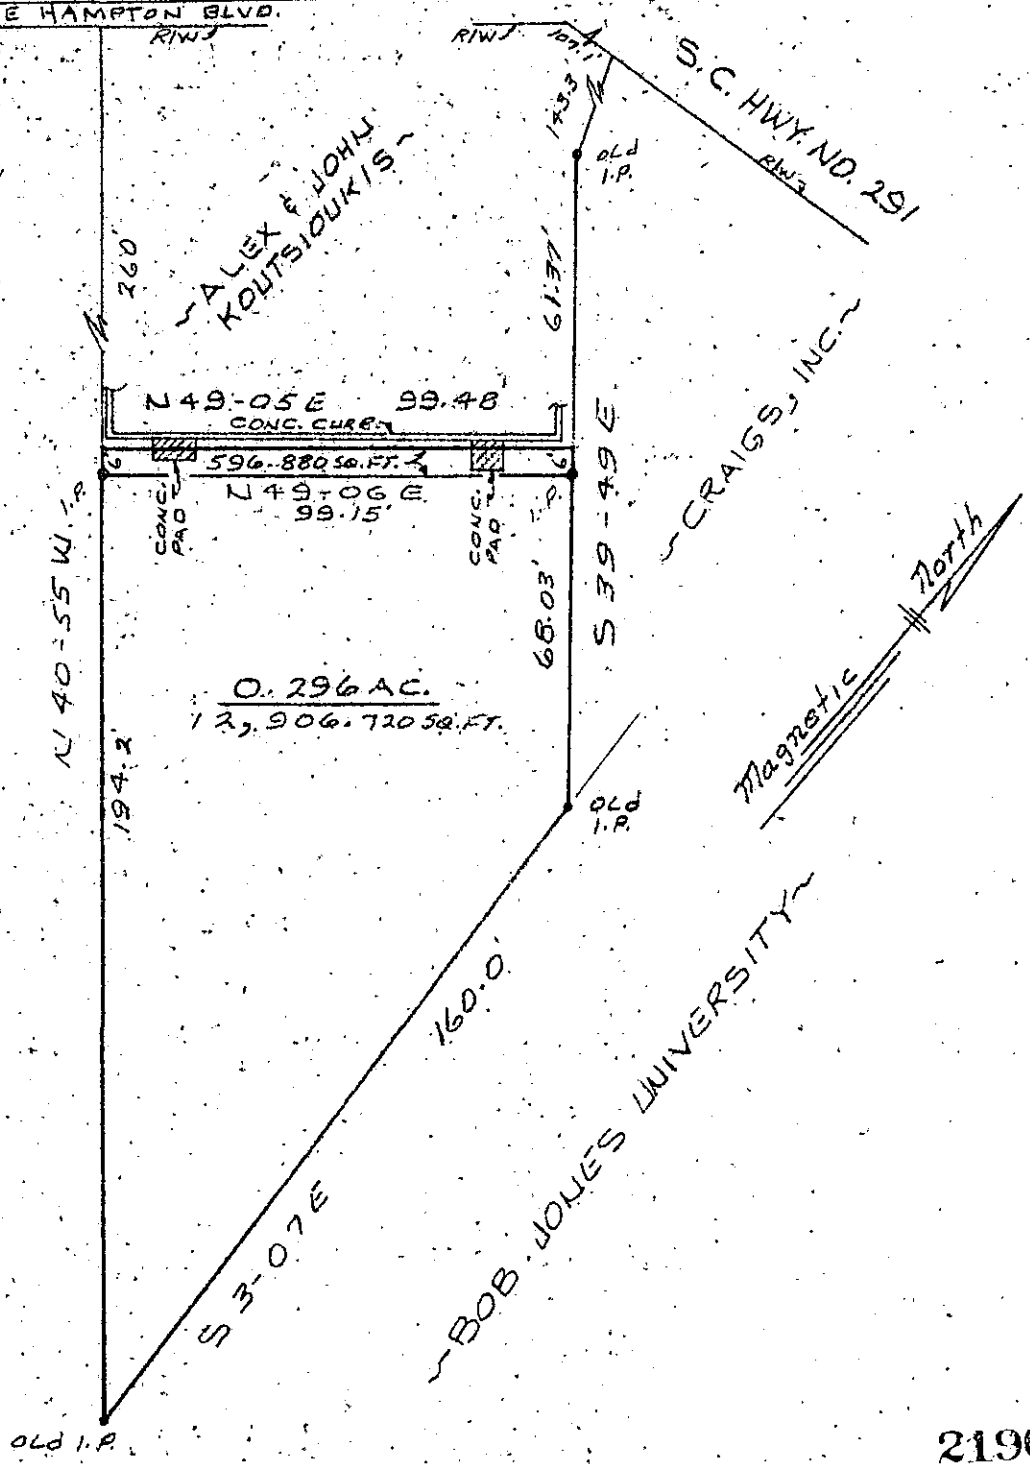


21906

SURVEY FOR  
BOB JONES UNIVERSITY, INC.  
GREENVILLE, S.C.  
SCALE 1"=40' - 9-20-76

6A-43  
MICROFILMED

FEB 18 '77

PIEDMONT ENGINEERS - ARCHITECTS - PLANNERS  
GREENVILLE, S.C.

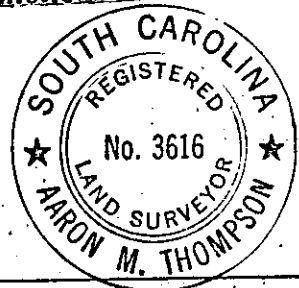

76 FEB 18 1977

1.00 AM