


BLAIR ST (ROSE ST)

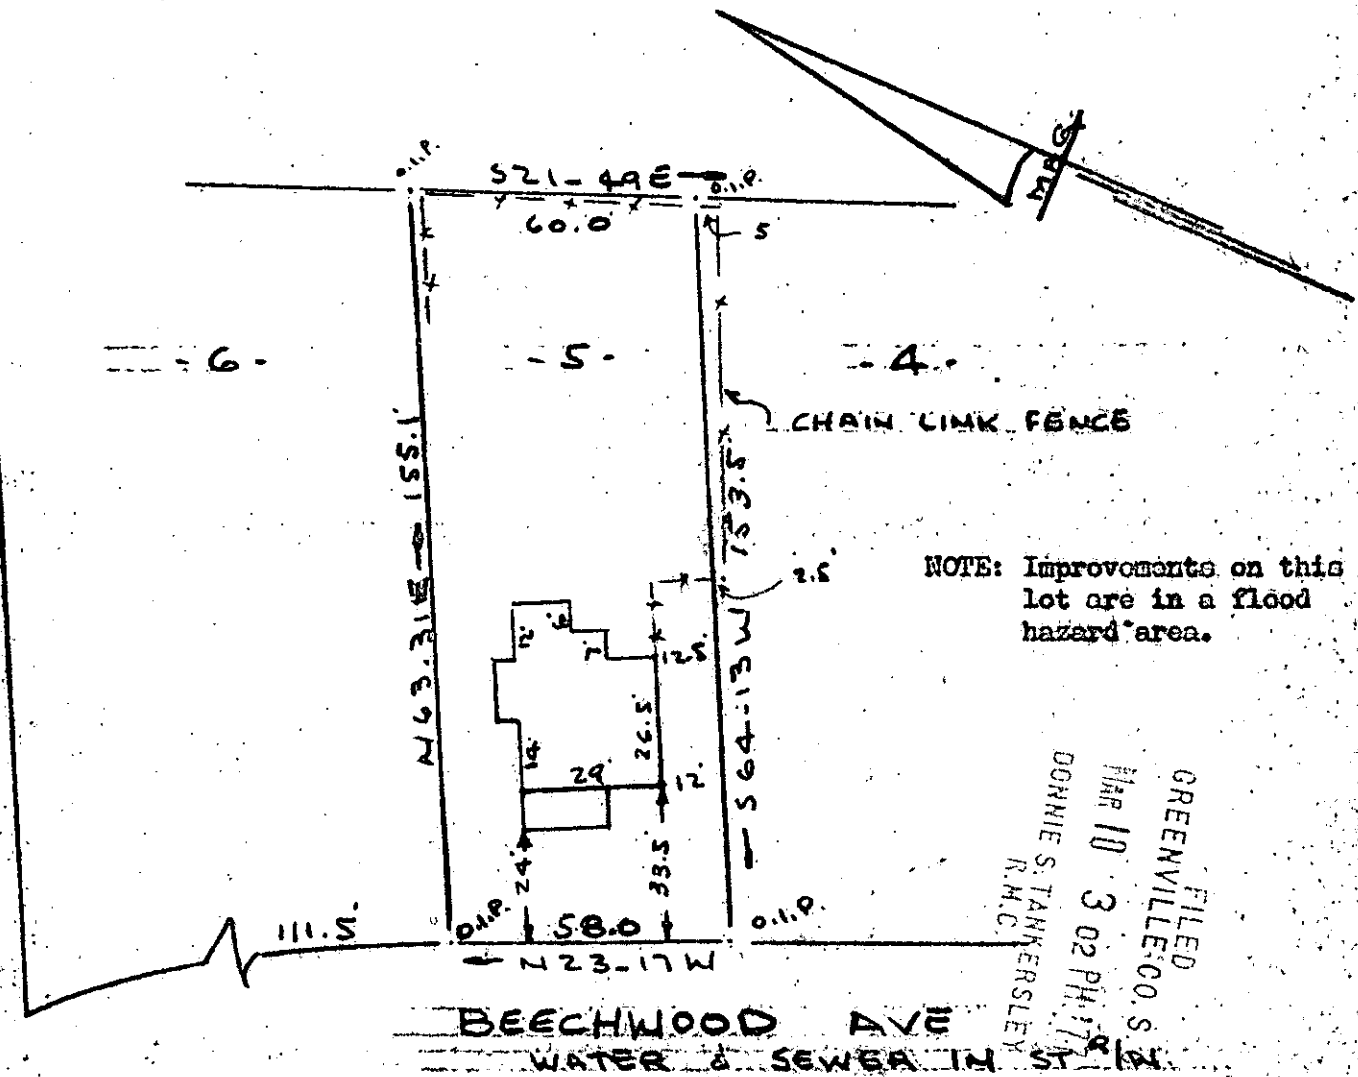

BEECHWOOD AVE  
WATER & SEWER IN ST

PROPERTY OF  
**MARCELL M. GOLDEN & MARTIN RAY GOLDEN**  
 GREENVILLE, S.C.  
 SCALE 1" = 40' 10 FEB 1977

This is to certify that on the 10th day of February 1977, I surveyed the property shown on this plat, being known as lot 5 on plat of MAP OF EAST OVER and recorded in the RMC Office Greenville County, S. C., in Plat Book "F" at Page 42; and also PROPERTY OF MARCELL M. GOLDEN & MARTIN RAY GOLDEN and recorded in Plat Book at Page ; and that the property lines, walls and buildings are as shown hereon, and that the walls and buildings located on said lot do not encroach or project on adjacent street or property, and that no adjacent street or property, and that no adjacent walls or buildings encroach or project on said premises, and no power lines cross this property except as shown hereon.

MICROFILMED  
R. B. Bruce  
 R. B. Bruce, RLS #1952

✓ 6-A-86 23880

7.85 MAR 10.C

1.00 A4

CAROLINA SURVEYING CO.  
 112 Manly St., Greenville, S. C.

182 - 59