

- BOW STEEL -

- MARTIN, INC. -

N 0 - 30 E

271.5'


PIEDMONT NATUREL GAS MAIN

35'

- 3 -

35' R/W FROM TRACK

170.1'  
AIR BASE

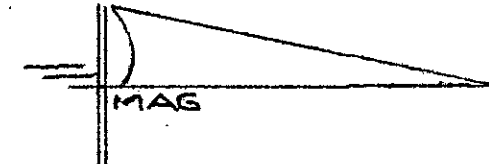

MICROFILMED

- CUTLER RIDGE -

- 32 -

N 89 - 30 W

33.8

30.6'  
BLOCK GARAGE

45.0

55.5

153.8'  
S 3 - 32 E  
ROSALEE DRIVE (ROSIE LEE DRIVE)  
WATER & SEWER IN ST. R/W

NOTE: Improvements on this lot are not in a flood hazard area.

PROPERTY OF

WADE ALLEN BRADLEY

NEAR GREENVILLE, S.C.

SCALE 1" = 40' 31 MAR 1977

This is to certify that on the 31st day of March 1977, I surveyed the property shown on this plat, being known as lot 3 on plat of PROPERTY OF J. I. SKELTON and recorded in the RMC Office Greenville County, S. C., in Plat Book " HHH " at Page 159; and that the property lines, walls and buildings are as shown hereon, and that the walls and buildings located on said lot do not encroach or project on adjacent street or property, and that no adjacent walls or buildings encroach or project on said premises, and no power lines cross this property except as shown hereon. Also known as PROPERTY OF WADE ALLEN BRADLEY and recorded in the RMC Office Greenville County, S. C., in Plat Book at Page

*R. B. Bruce*

R. B. Bruce, RLS #1952

26628

3 6 0 APR 6 E

1.00 A8

CAROLINA SURVEYING CO.  
112 Manly St.  
Greenville, S. C.

16B-51

APR 6 '77