

NOTE: Plat amended Sept. 14 1977 to show 8.12 Acres cut out.




John A. Simmons


PROPERTY OF  
**JAMES T. & ANNA LORA WINGARD.**  
 Located 2 1/2 miles South of Clearview Baptist Church.  
 PARIS MOUNTAIN TOWNSHIP GREENVILLE COUNTY,  
 SOUTH CAROLINA.

SCALE: 1" = 200 FEET. MARCH 14, 1959.  
 Survey made March 1959.

H.S. BROCKMAN, Reg. Surveyor #959,  
 GREER, S.C.  
 John A. Simmons - Draftsman.

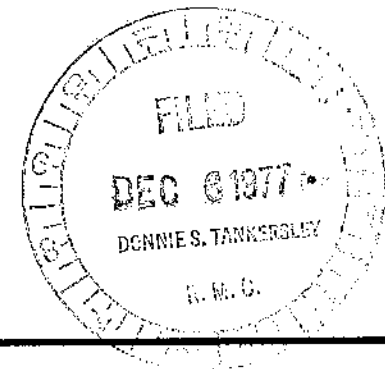

17368

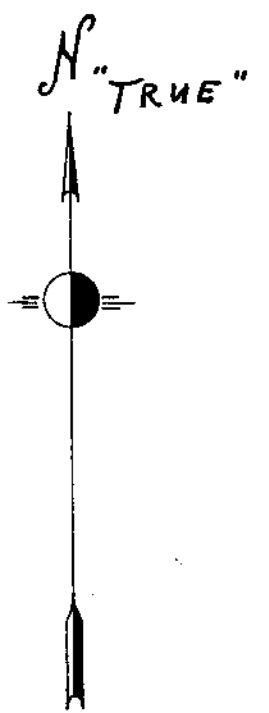

✓6-C-97

MICROFILMED

600-2 DE06 77 553

82/43