


Box 327  
Route 4 Hudson Rd.

FILED  
GREENVILLE CO. S. C.

MAY 20 2 59 PM '77  
-DONNIE S. TANKERSLEY  
R.M.C. 10-

DEL NORTE ESTATOS  
DEL NORTE BLYD.

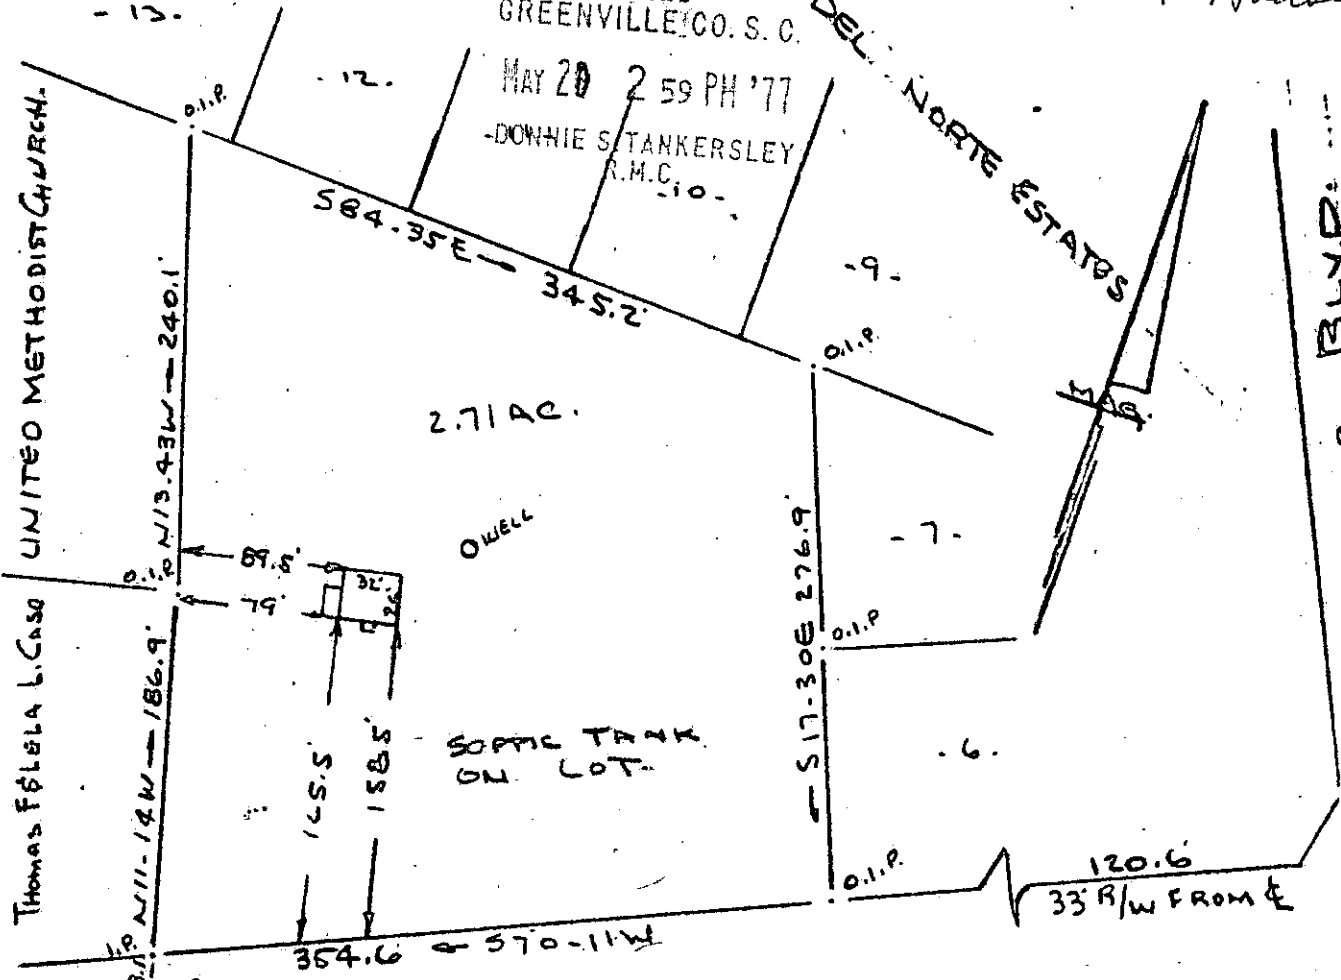

HUDSON ROAD


NOTE: Improvements on this lot are not in a flood hazard area.

PROPERTY OF  
JAMES A. DUCKETT SR & GAY N. DUCKETT  
NEAR GREENVILLE, S.C.  
SCALE 1" = 100' 18 MAY 1977

89 4N 20M

This is to certify that on the 18th day of May, 1977, I surveyed the property shown on this plat, being known as PROPERTY OF JAMES A. DUCKETT & GAY N. DUCKETT and recorded in the REC Office Greenville County, S. C., in Plat Book at Page ; and that the property lines, walls and buildings are as shown hereon, and that the walls and buildings located on said property do not encroach or project on adjacent street or property, and that no adjacent walls or buildings encroach or project on said premises, and no power lines cross this property except as shown hereon.

R. B. Bruce  
R. B. Bruce, RLS 1/1952

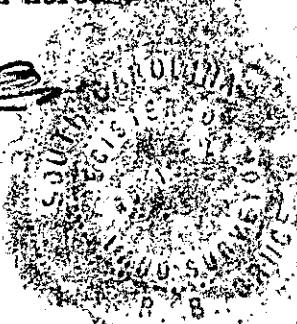

6-D-59

31645

CAROLINA SURVEYING CO.  
112 Manly St., Greenville, S. C.

MICROFILMED

1.00 AS