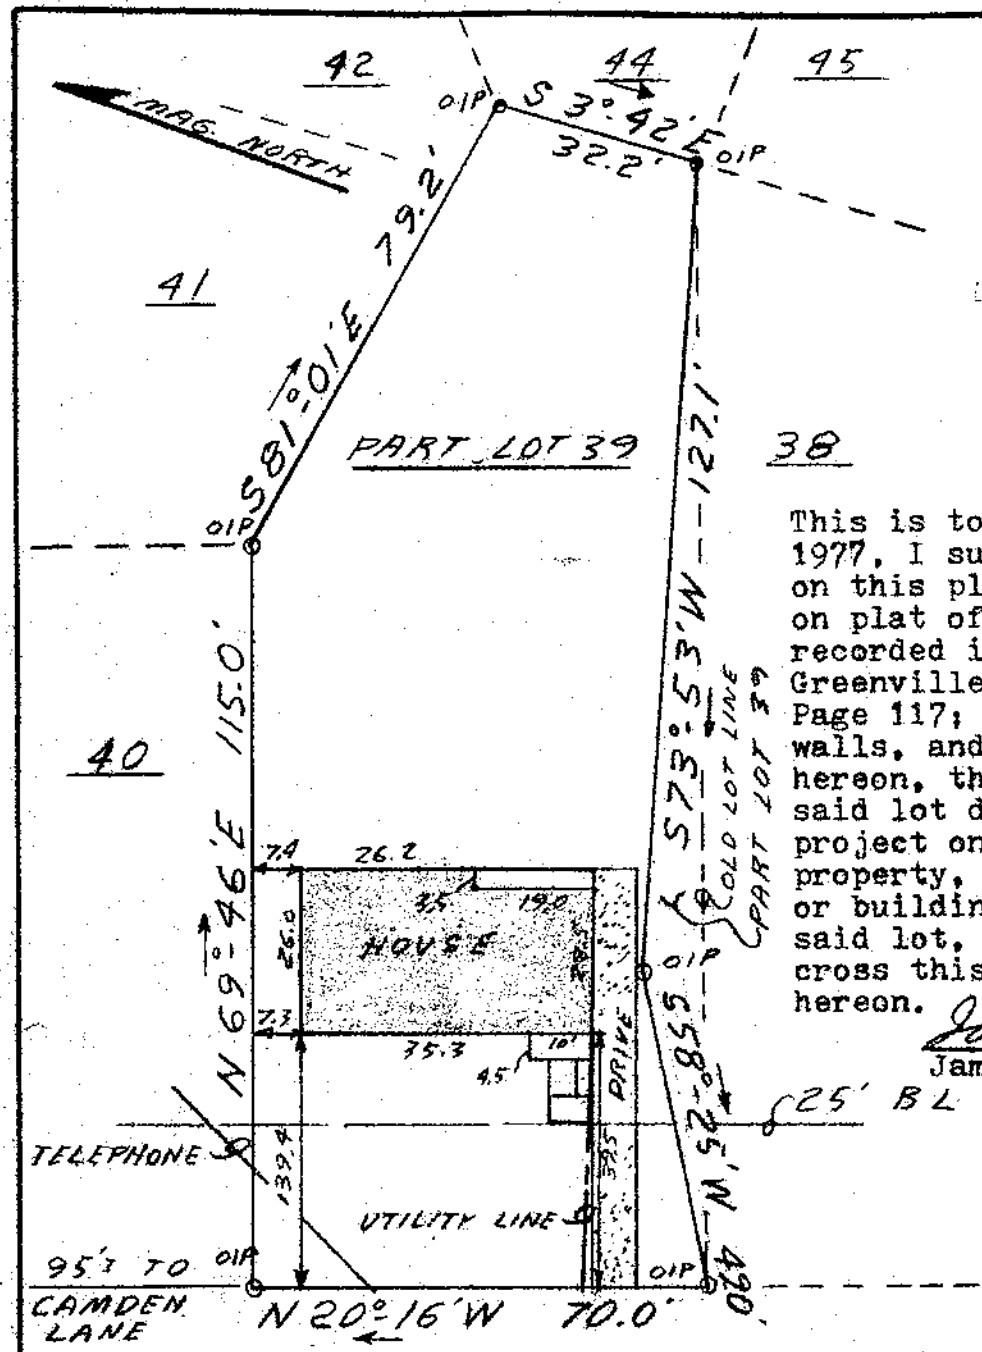

Note: There is a 5 ft. drainage & utility easement along all side and rear lot lines.

GREENVILLE CO. S.C.
MAY 31 3 17 PM '77
DONNIE S. TANKERSLEY
R.M.C.

This is to certify that on May 25, 1977, I surveyed the property shown on this plat, known as part lot 39 on plat of Belle Meade - Sect. 1&2, recorded in the R.M.C. Office of Greenville County in Plat Book EE on Page 117; and that the property lines, walls, and buildings are as shown hereon, that the building located on said lot does not encroach or project on adjacent streets or property, and that no adjacent walls or buildings encroach or project on said lot, and that no utility lines cross this property except as shown hereon.

James R Freeland

James R. Freeland, RLS 4781

BROOK FOREST DRIVE

WATER & SEWER IN ST. R/W

32888

MICROFILMED

This property is not located in a major flood plain.

6-D-85

MAY 31 1977

SOUTH CAROLINA
REGISTERED LAND SURVEYOR
No. 4781
JAMES RALPH FREELAND

SEAL

STATE OF SOUTH CAROLINA
GREENVILLE COUNTY

BELLE MEADE

SECT. 2 - LOT 39

100 M PROPERTY OF
GLENN T. DORSEY &
VIVIAN G. DORSEY

FREELAND & ASSOCIATES
Engineers • Land Surveyors
GREENVILLE, S. C.

SURVEY	M.C.
DRAWN	JRF
CHECK	JRF
SCALE	1" = 30'
DATE	5-25-77
DWG. NO.	77-1570