


OVERBROOK ROAD

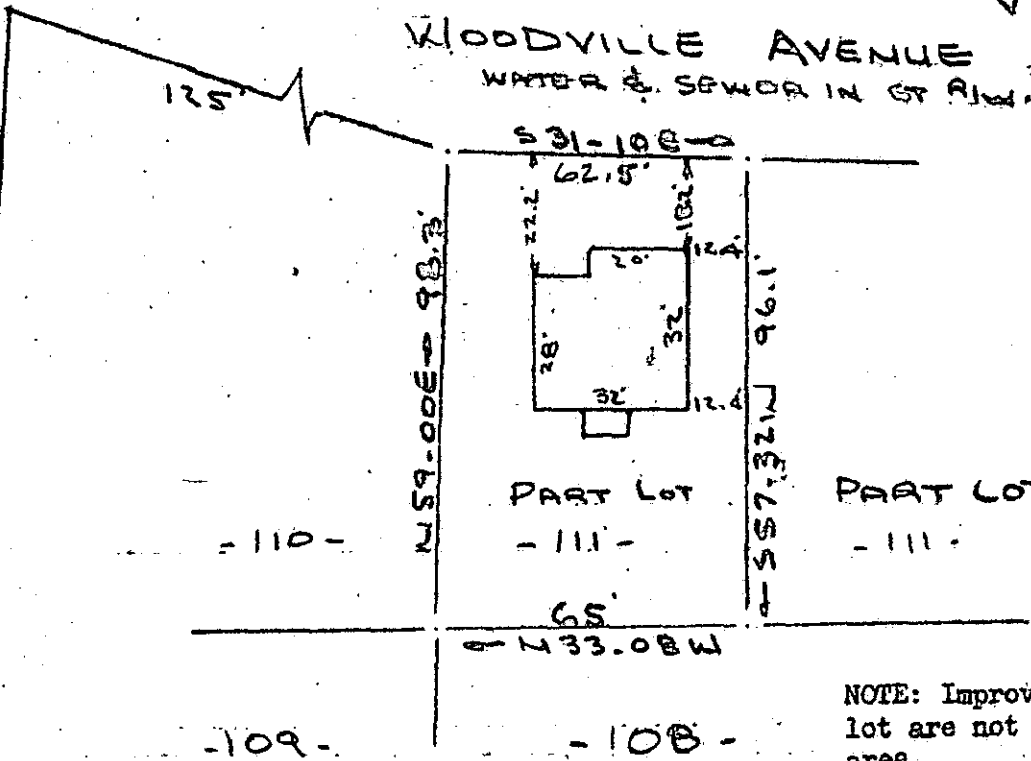

FILED
 GREENVILLE CO. S. C.
 MAY 31 3 29 PM '77
 DONNIE S. TANKERSLEY
 R.M.C.

NOTE: Improvements on this lot are not in a flood hazard area.

PROPERTY OF
 JAMES PERRY HARRISON & GLORIA S. HARRISON
 GREENVILLE, S. C.
 SCALE 1" = 40' 18 MAY 1977

This is to certify that on the 18th day of May, 1977, I surveyed the property shown on this plat, being known as part of lot 111 on plat of Plat No. 3 PROPERTY OF OVERBROOK LAND CO. and WOODVILLE INV. CO. and recorded in the RMC Office Greenville County, S. C., in Plat Book " F " at Page 218 and also being known as property of JAMES PERRY HARRISON & GLORIA S. HARRISON and recorded in the RMC Office in Plat Book at Page and that the property lines, walls and buildings are as shown hereon, and that the walls and buildings located on said lot do not encroach or project on adjacent street or property, and that no adjacent walls or buildings encroach or project on said premises, and no power lines cross this property except as shown hereon.

6-10-86 ✓

R. B. Bruco
 R. B. Bruco, RLS #1952

32890

O. B. 17 MAY 31 C

1.00 A4

CAROLINA SURVEYING CO.
 112 Rnly St.
 Greenville, S. C.

MICROFILMED