


FILED
GREENVILLE CO. S. C.

JUL 29 4 40 PM '77

WILLIAM S. TANNER, SLE.
R.M.C.

- JAMES IRVIN WALKER -

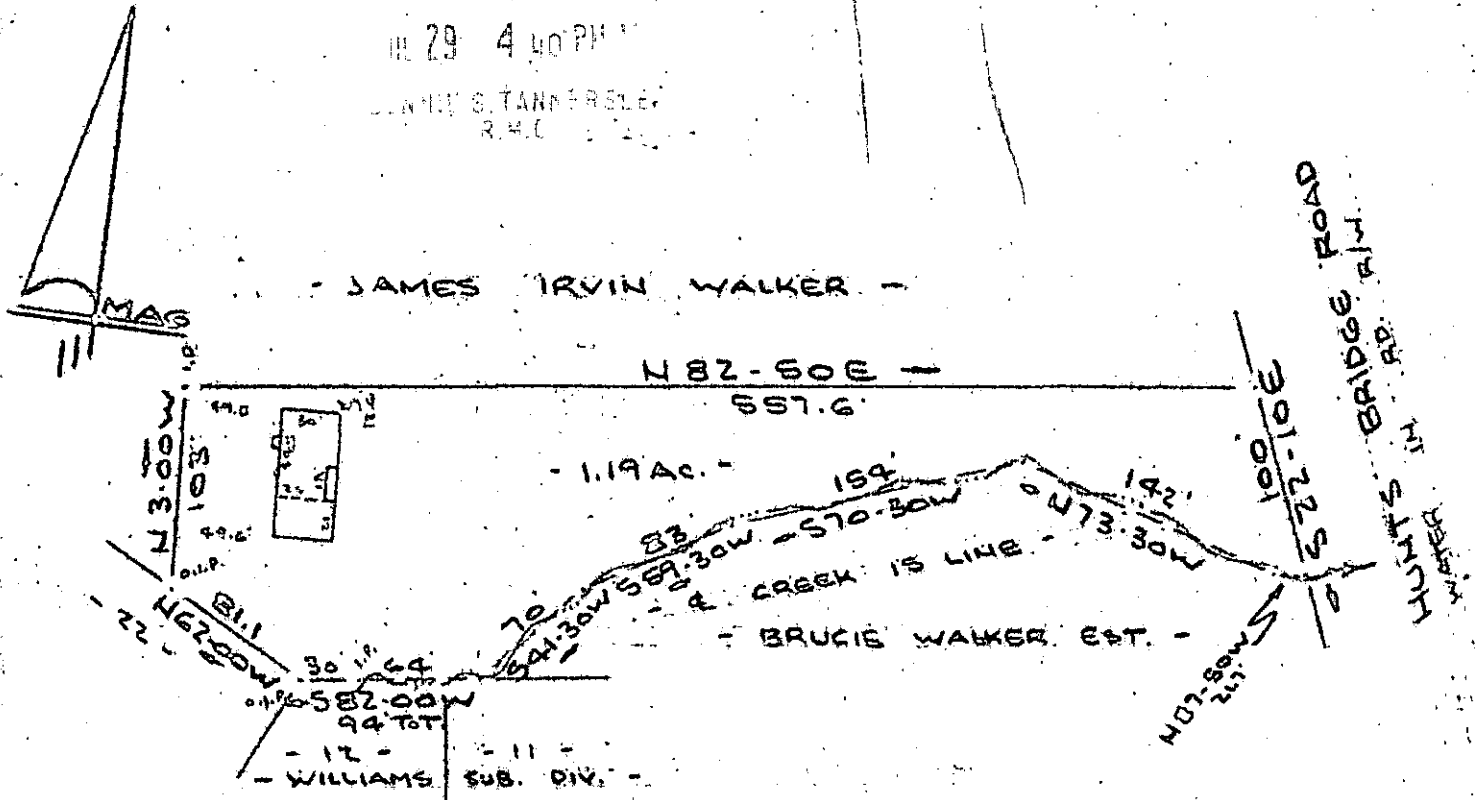


NOTE: Improvements on this lot are not in a flood hazard area.

PROPERTY OF
JAMES I. WALKER & JANIE B. WALKER
NEAR GREENVILLE, S. C.
SCALE: 1" = 100' 23 JULY 1977

This is to certify that on the 28th day of July, 1977, I surveyed the property shown on this plat, being known as 1.19 acres on plat of PROPERTY OF JAMES I. WALKER AND JANIE B. WALKER and recorded in the REC Office Greenville County, S. C., in Plat Book at Page ; and that the property lines, walls and buildings are as shown hereon, and that the walls and buildings located on said lot do not encroach or project on adjacent street or property, and that no adjacent walls or building encroach or project on said premises, and no power lines cross this property except as shown hereon.

R. B. Bruce

R. B. Bruce, RLS 21952

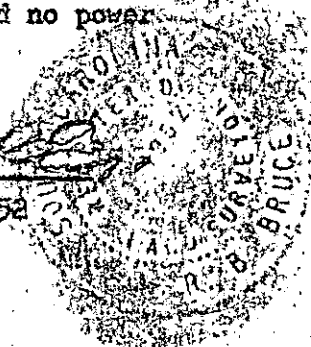

3210

✓ 6-B-7

JUL 29 '77

CAROLINA SURVEYING CO.
112 Manly St.
Greenville, S. C.
1.00 A8

MICROFILMED