

This property is not located in a major flood plain.


200' TO RUTHERFORD RD. N 76° 45' W 100.0' WATER & SEWER IN ST. R/W  
**PIEDMONT AVENUE**

This is to certify that on August 17, 1977, I surveyed the property shown on this plat, known as Part Lot 3 on Plat of McCain Heights, recorded in the RMC Office of Greenville County in Plat Book J on Page 59, and that the property lines, walls and buildings are as shown hereon; that the building located on said lot does not encroach or project on adjacent streets or property, and that no adjacent walls or buildings encroach or project on said premises, and that no utility lines cross this property except as shown hereon.

5931  
*James R. Freeland*  
 James R. Freeland RLS & PE 4781

AUG 23 11 15 AM '77  
 DONNIE S. TANKERSLEY  
 R.M.C.

1 6 7 2 1 1/2  
 P26-1-20.1 6-G-53

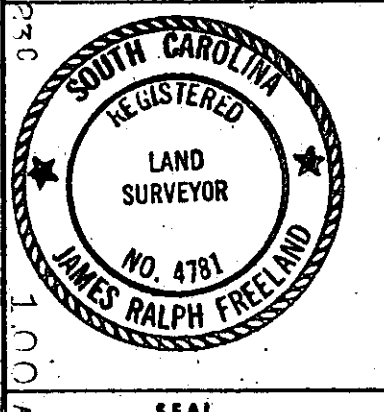

**STATE OF SOUTH CAROLINA GREENVILLE COUNTY**  
 MICROFILMED  
**McCAIN HEIGHTS**  
 PART LOT 3  
 PROPERTY OF  
**KENNETH E. MARTIN & IRENE MARTIN**

**FREELAND & ASSOCIATES**  
 Engineers • Land Surveyors  
 GREENVILLE, S. C.

SURVEY	M.C.
DRAWN	M.C.
CHECK	JAF
SCALE	1" = 40'
DATE	8-16-77
DWG. NO.	77-171B