


FILED
GREENVILLE CO. S. C.

"THIS PROPERTY IS NOT LOCATED IN A FLOOD PLAIN."

SEP 2 4 05 PM '77

DONNIE S. TANKERSLEY
R.M.C.

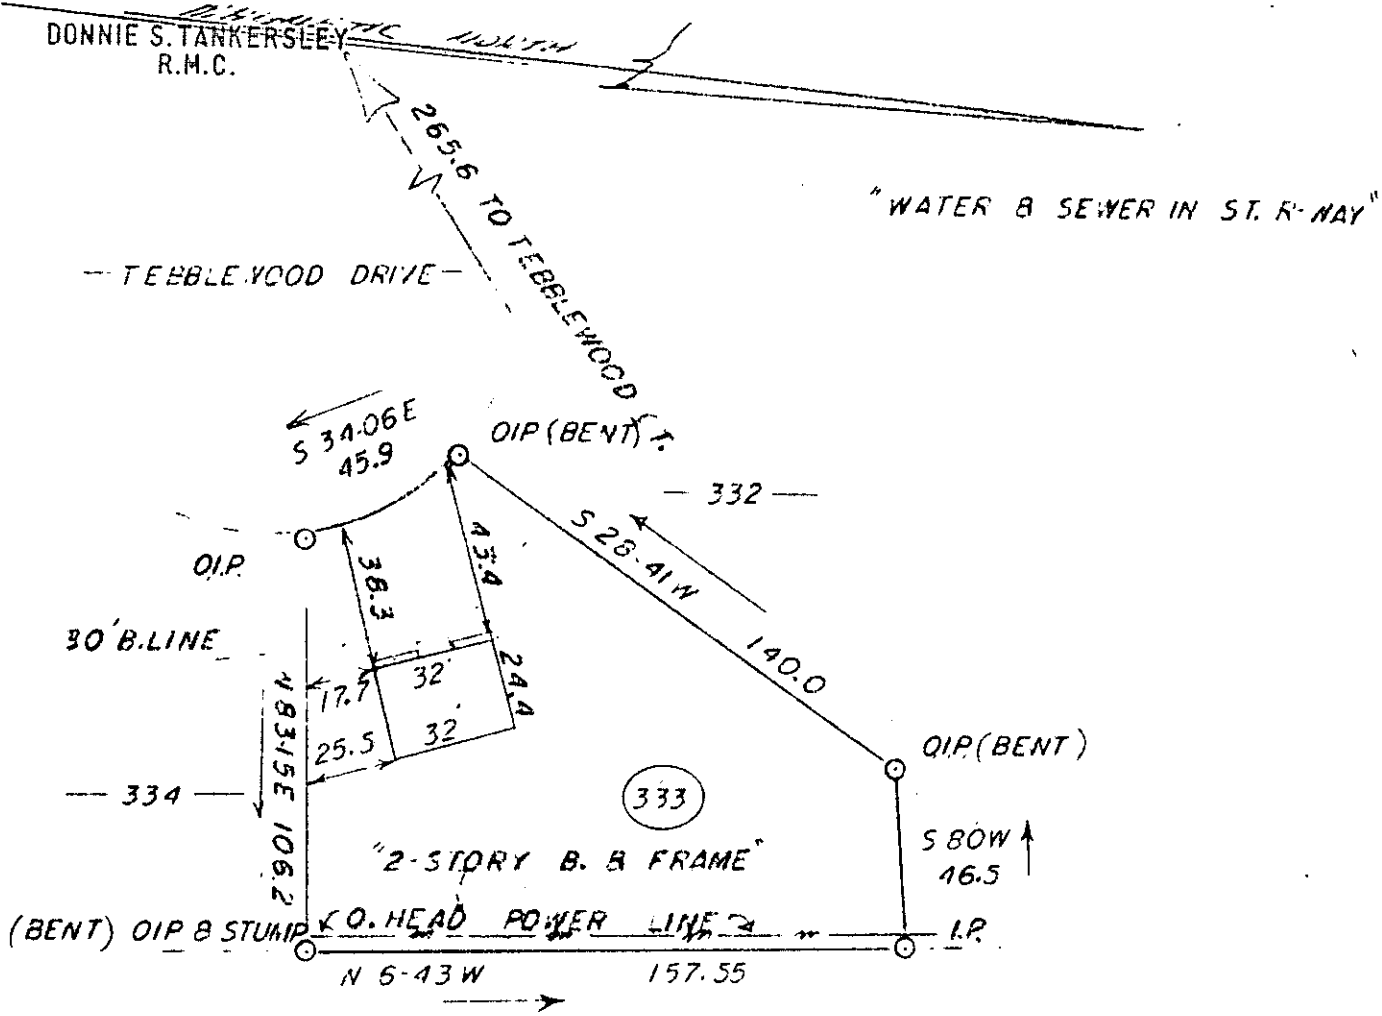

WILLIAM N. and TEDDY G. TRKSAK

SIMPSONVILLE, S. C.

SCALE: 1"=50'

THIS IS TO CERTIFY THAT ON THE 31 ST DAY OF AUGUST, 1977, I SURVEYED THE PROPERTY SHOWN ON THIS PLAT, BEING KNOWN AS LOT 333 ON PLAT OF YAWOOD NO. 4 AND RECORDED IN THE R. M. C. OFFICE GREENVILLE COUNTY, S. C. IN PLAT BOOK 7-6 AT PAGE 30; AND THAT THE PROPERTY LINES, WALLS, AND BUILDINGS ARE SHOWN HEREON, AND THAT THE WALLS AND BUILDINGS LOCATED ON SAID LOT DO NOT ENCROACH OR PROJECT ON ADJACENT STREETS OR PROPERTY, AND THAT NO ADJACENT WALLS OR BUILDINGS ENCROACH OR PROJECT ON SAID PREMISES, AND NO POWER LINES CROSS THIS PROPERTY EXCEPT AS SHOWN HEREON.



7422 ✓ 6G-75 MICROFILMED
 1.00 A4 J. L. MONTGOMERY, III
 R. L. S. No. 4552
 Simpsonville, S. C.

SEP 2 1977