


FILED
GREENVILLE CO. S. C.
SEP 9 5 03 PM '77
DONNIE S. TANKERSLEY
R.M.C.

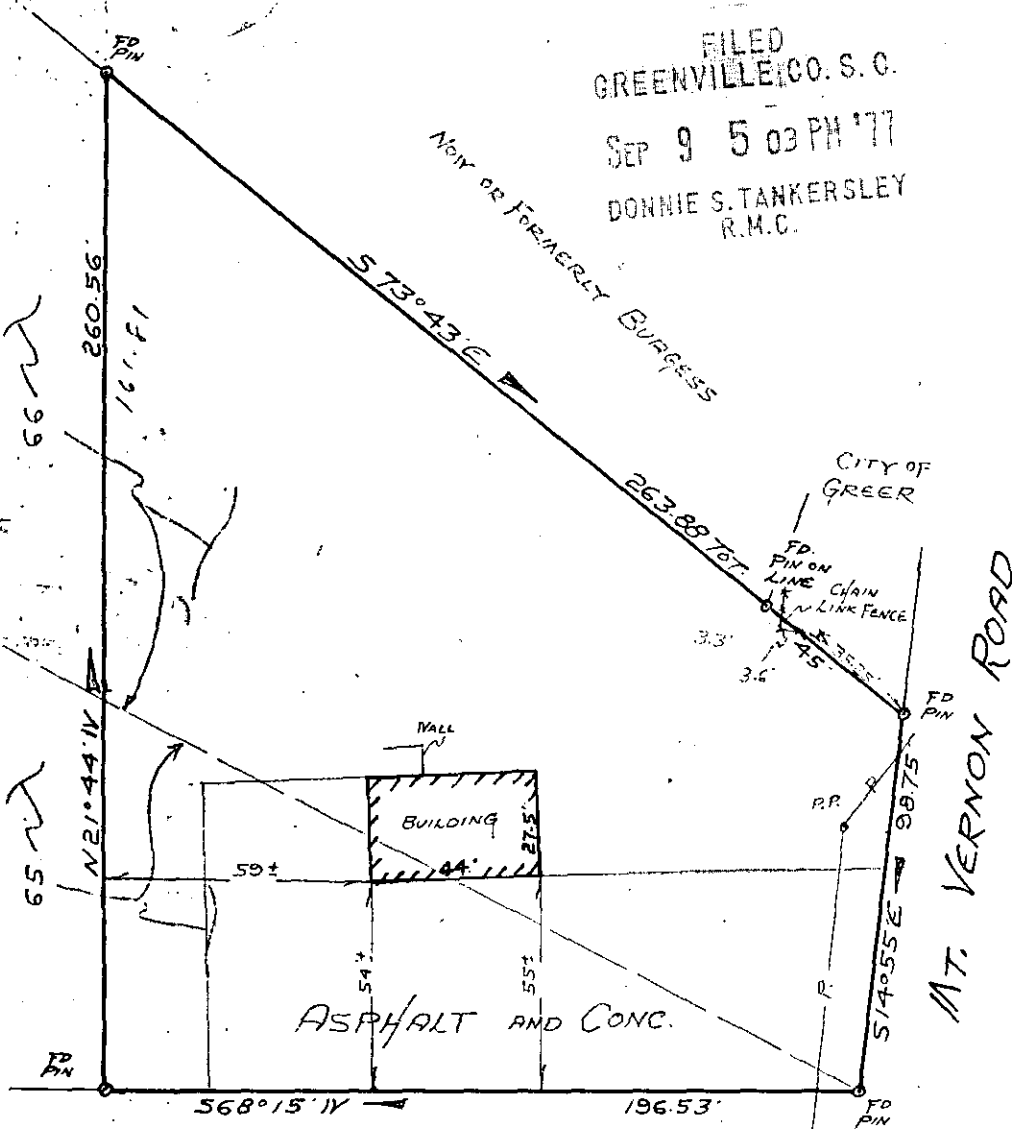

U.S. HIGHWAY No 29
WADE HAMPTON BLYD.

PROPERTY OF
J. V. ROBINSON
GREER, SOUTH CAROLINA
SCALE 1"=50' AUG 2, 1977

FILED
GREENVILLE CO. S. C.
SEP 9 5 02 PM '77
DONNIE S. TANKERSLEY
R.M.C.

This is to certify that on August 2, 1977, I surveyed the property shown on this plat, known as Property of J. V. Robinson, and that the property lines, walls and building are as shown hereon, and that the building located on said lot does not project nor encroach on adjacent streets or property, and that no adjacent walls or buildings project nor encroach on said lot, and that no utility lines cross this lot except as may be shown hereon.

MICROFILMED

✓ 6 G - 90 8027

SEP 9 1977



100 RICHARD WOODEN & SONS SURVEYING

SCRLS. No 4678