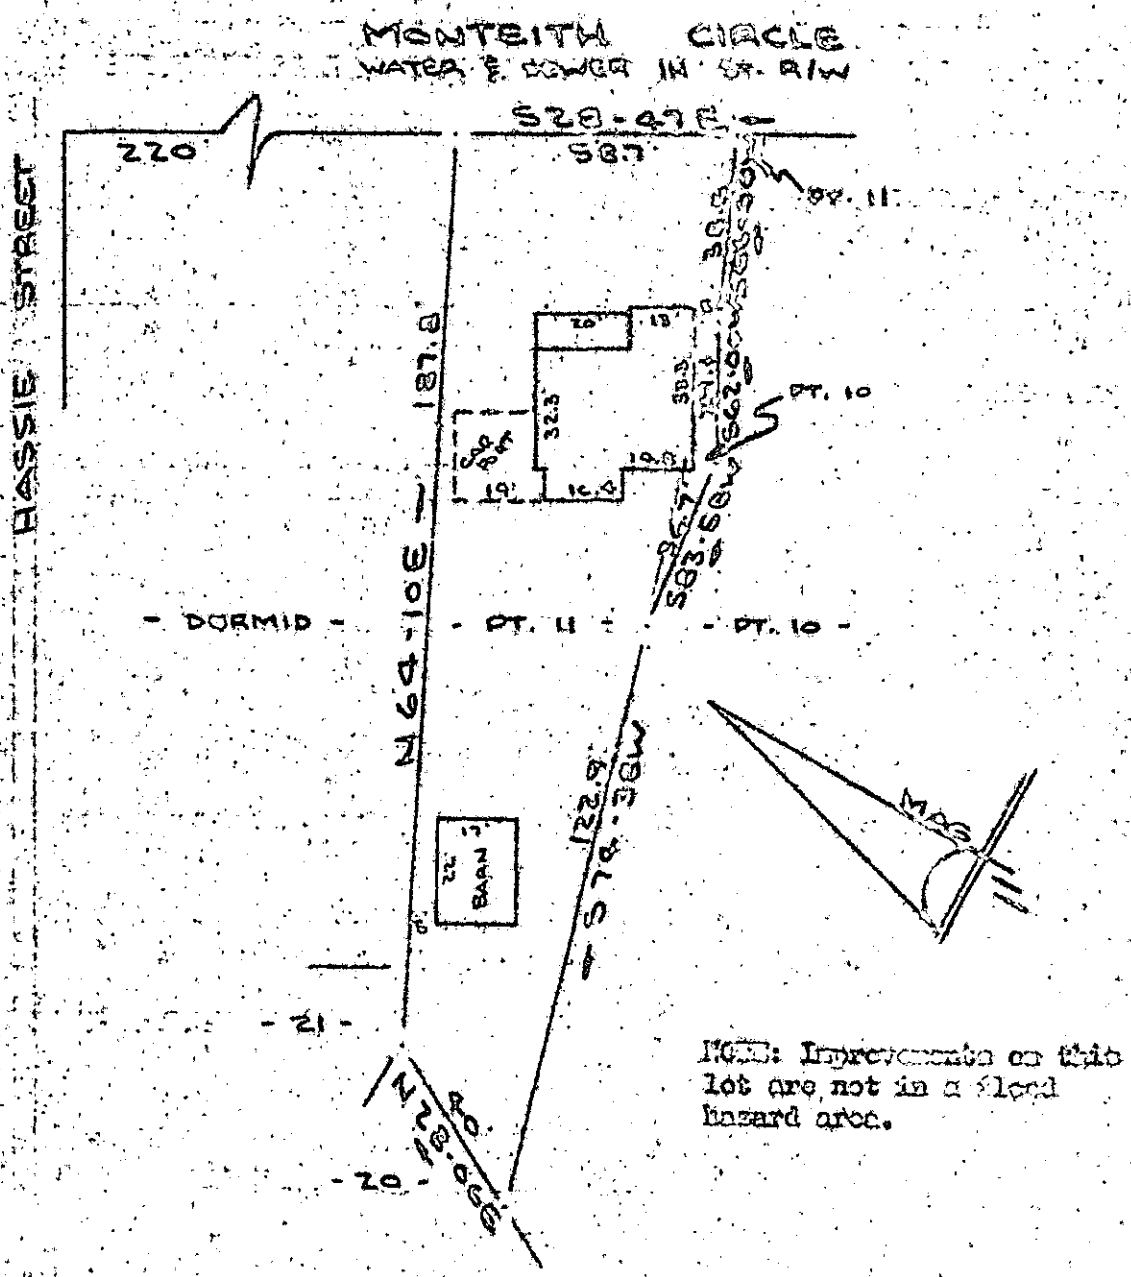

PROPERTY OF

HERBERT J. CASON JR. & BARBARA L. CASON

GREENVILLE, SOUTH CAROLINA

SCALE: 1" = 40'

This is to certify that on the 15th day of September, 1977, I surveyed the property shown on this plat, being known as part of lot 10 and part of lot 11 on plat of PROPERTY OF EDGAR JANION JR & BRENDA L. JANION and recorded in the RMC Office Greenville County, S. C., in Plat Book " 4 - H " at Page 21; and that the property lines, walls and buildings are as shown hereon, and that the walls and buildings located on said lot do not encroach or project on adjacent street or property, and that no adjacent walls or buildings encroach or project upon said premises, and no power lines cross this property except as shown hereon. Also known as PROPERTY OF HERBERT J. CASON, JR. & BARBARA L. CASON (as recorded in the RMC Office Greenville County, S. C., in Plat Book at Page

R. B. Bruce, PLS

CAROLINA SURVEYING CO.

112 Holly St., Greenville, S. C.

R. B. BRUCE 6351 REGISTERED LAND SURVEYOR

6-I-12

8966

MICROFILMED

GREENVILLE CO. S. C.
SEP 19 11 16 AM '77
DONNIE S. TANKERSLEY
1 5 78 SEP 19 98
100 96