


NOTE: Improvements on this lot are not in a flood hazard area.

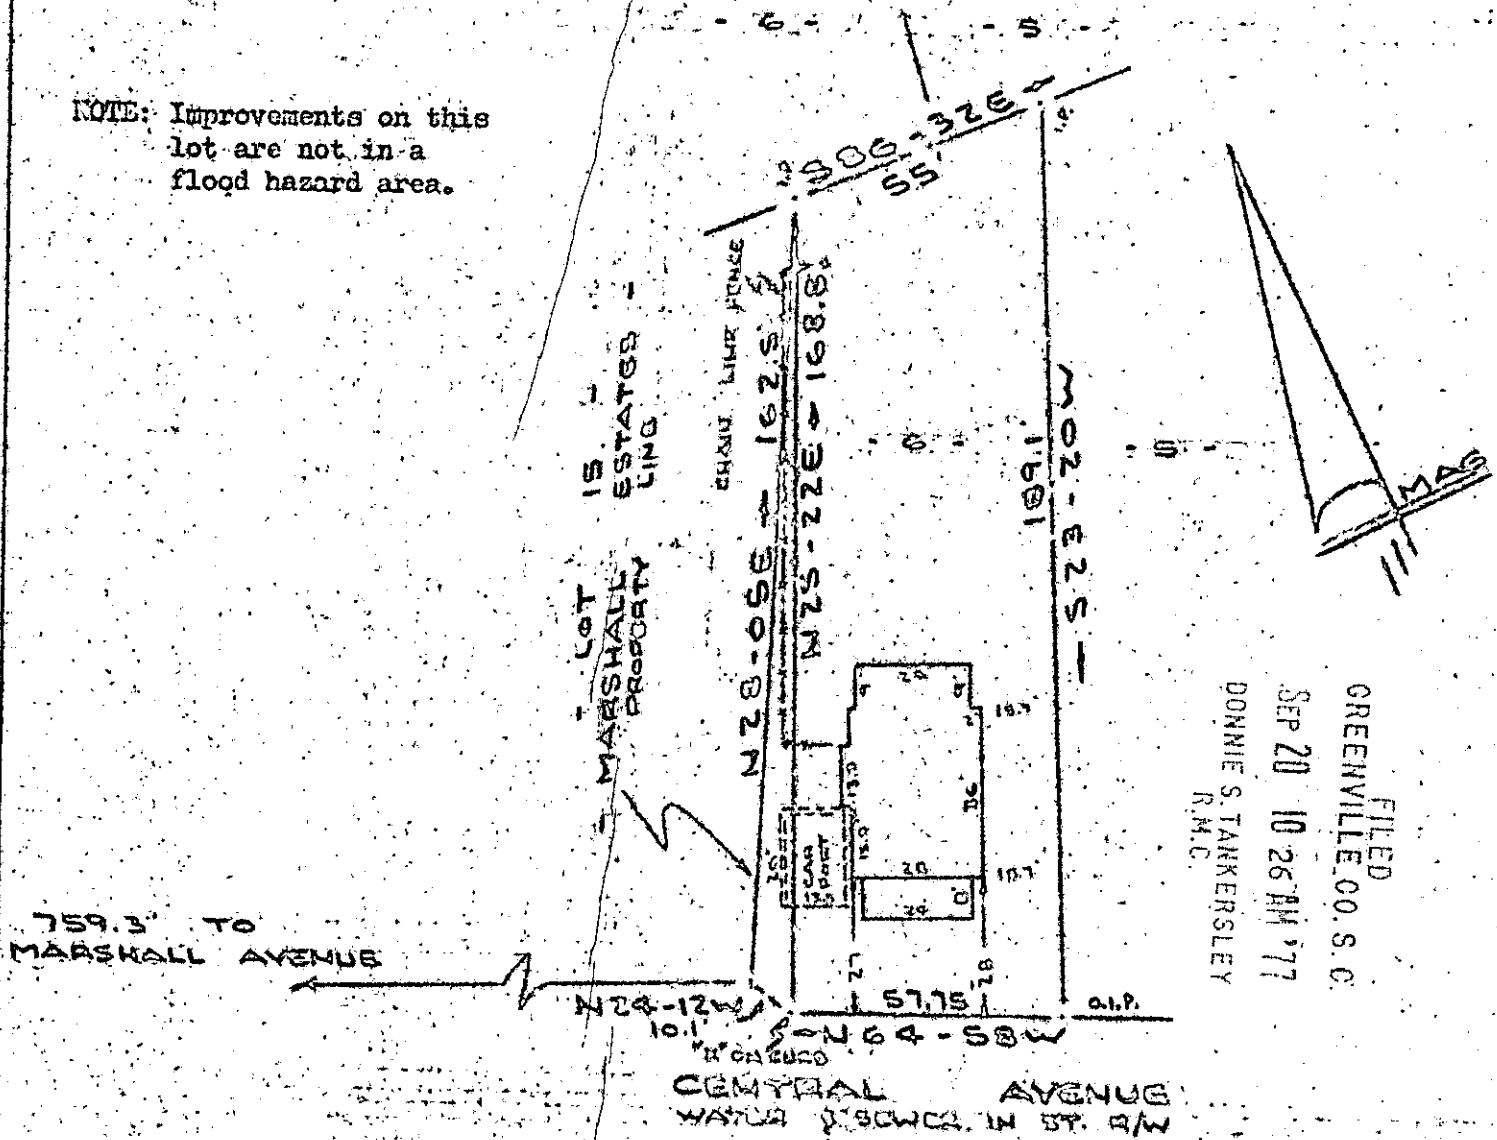

PROPERTY OF
DONALD T. BUDDIN
 GREENVILLE, SOUTH CAROLINA
 SCALD 11-22 16 SEP 1977

This is to certify that on the 10th day of September, 1977, I surveyed the property shown on this plat, being known as lot 6 on plat of GREENLEY & ROSS REAL ESTATE PROPERTY and recorded in the REC OFFICE Greenville County, S. C., in Plat Book "B" at Page 27, and also being known as PROPERTY OF DONALD T. BUDDIN and recorded in the REC OFFICE Greenville County, S. C., in Plat Book at Page ; and that the property lines, walls and buildings are as shown hereon, and that the walls and buildings located on said lot do not encroach or project on adjacent street or property, and that no walls or buildings encroach or project on said premises, and no cross this property except as shown hereon.

MICROFILMED

R. B. E.
 R. B. E. S. S.

✓ 6 I - 15

SAROLINA GREENVILLE CO.
 112 N. Main Street
 Greenville, S.C. 29601

9059