


FILED
 GREENVILLE CO. S. C.
 OCT 4 11 08 AM '77
 DONNIE S. TANKERSLEY
 R.M.C.

CHILDRESS CIRCLE
 WATER & SEWER IN ST. RW

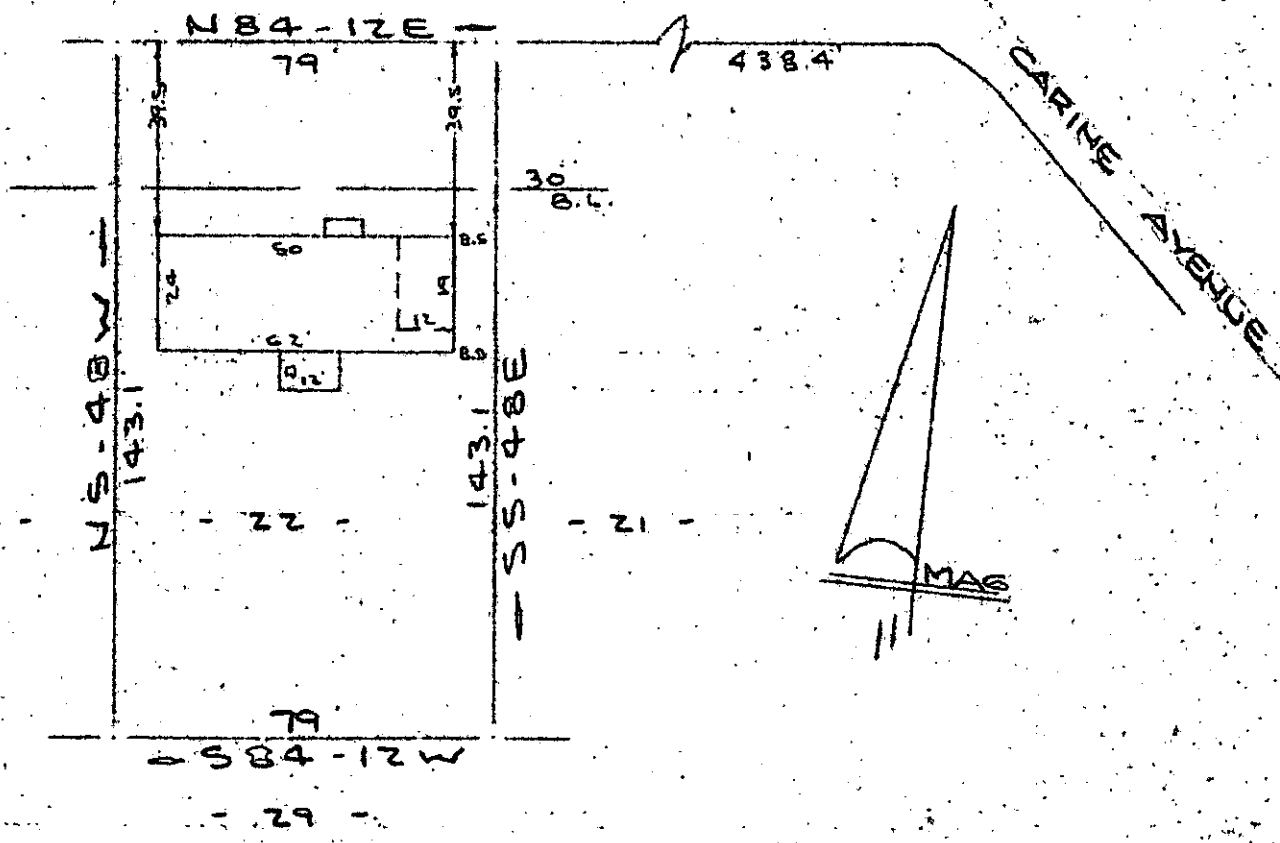

PROPERTY OF
 DENNIS G. MORT & LINDA MORT
 NEAR GREENVILLE, S. C.
 SCALE: 1" = 40' 30 SEPT 1977

This is to certify that on the 30th day of September 1977, I surveyed the property shown on this plat, being known as lot 22 on plat of 'MCNAUL' and recorded in the R.M.C. Office Greenville County, S. C. in plat book 4 N. page 52; and that the property lines, walls and buildings are as shown hereon, and that the buildings located on said lot do not encroach or project on adjacent street or property, and that no adjacent buildings or walls encroach or project on said premises, and that no power lines cross said property except as shown hereon.

✓ 6-I-45

OCT 4 '77

10633

R. B. Bruce
 R. B. BRUCE
 R. 12th S. 1932
 NO. 1952



MICROFILMED

CAROLINA SURVEYING COMPANY
 112 Fanny Street, Greenville, S.C.