

FILED
GREENVILLE CO. S. C.


NOTE: Improvements on this lot are not in a flood hazard area.

OCT 20 10 03 AM '77
DONNIE S. TANKERSLEY
R.M.C.

VEDADO LAKE
WATER & SEWER IN ST. RW

037500, 208

HOLLYWOOD DRIVE

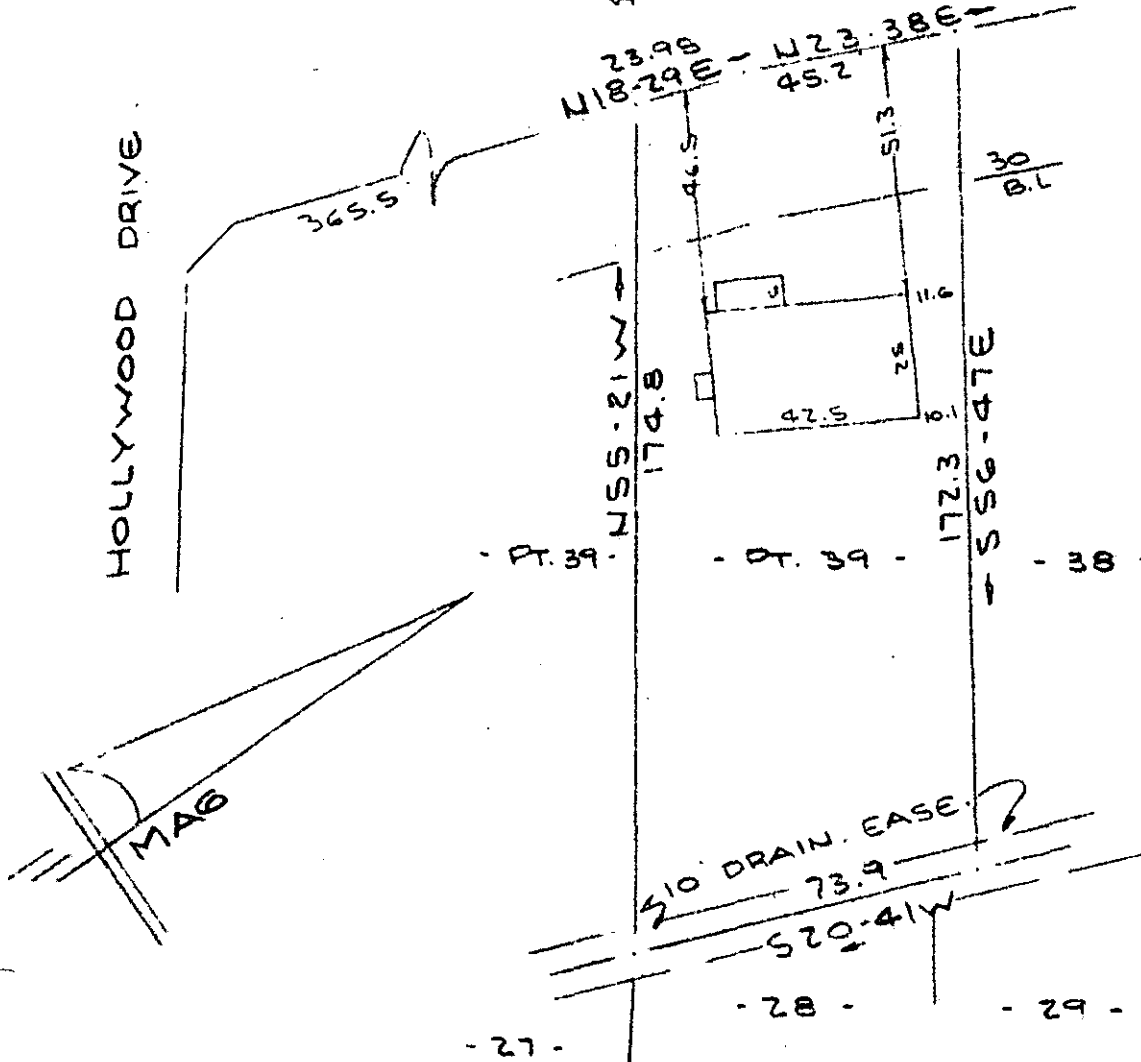

1.00 A6

MICROFILMED

PROPERTY OF
MAE D. JOHNSON
NEAR GREENVILLE, S. C.
SCALE: 1"=40
19 OCT 1977

OCT 20 '77

This is to certify that on the 19th day of October, 1977, I surveyed the property shown on this plat, being known as part of lot 39 on plat of SECTION 2 VARDRY VALE and recorded in the RMC Office Greenville County, S. C., in Plat Book " WW " at Page 53; and that the property lines, walls and buildings are as shown hereon, and that the walls and buildings located on said lot do not encroach or project on adjacent street or property, and that no adjacent walls or buildings encroach or project on said premises, and no power lines cross this property except as shown hereon. Also being known as PROPERTY OF MAE D. JOHNSON and recorded in the RMC Office Greenville County, S. C., in Plat Book at Page

R. B. Bruce
R. B. Bruce, RLS #1952 12414

CAROLINA SURVEYING CO.
112 Manly St.
Greenville, S. C.

61-84