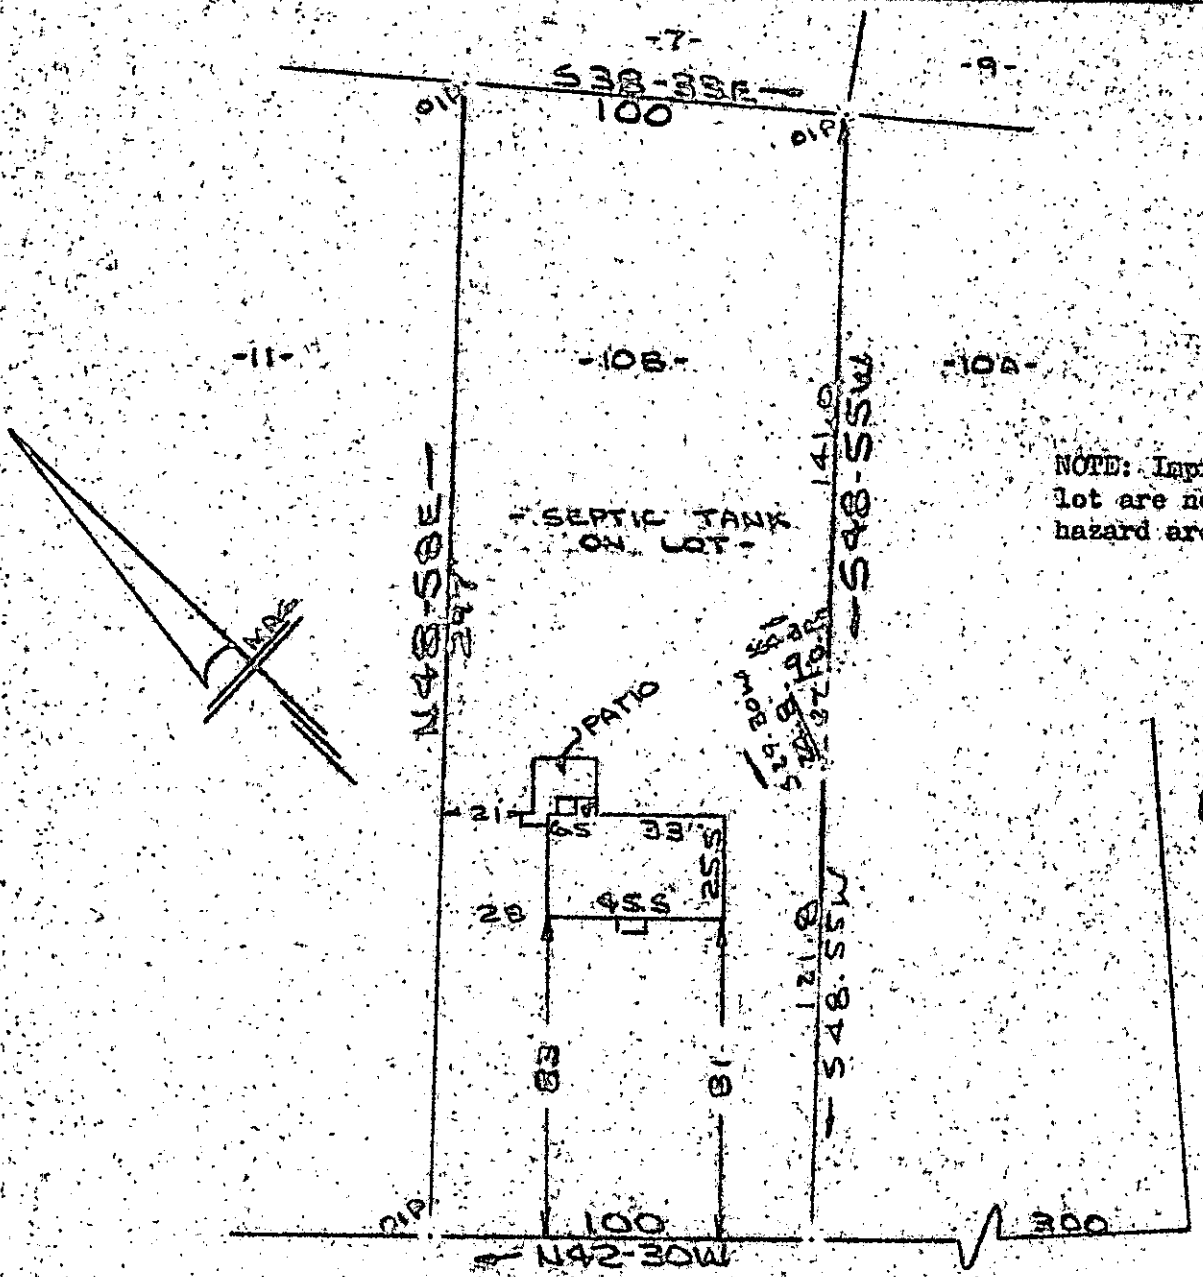

NOTE: Improvments on this lot are not in a flood hazard area.

PROPERTY OF

MICHAEL H. BROWN & LONNIE F. BROWN

NEAR GREENVILLE, S.C.

SCALE: 1" = 50' 16 NOV. 1977

This is to certify that on the 16th day of November, 1977, I surveyed the property shown on this plat, being known as lot 10 B on plat of L. W. JONES ESTATE Plat No. 2 recorded in the RMC Office Greenville County, S. C., in Plat Book " P " at Page 362 and also being known as PROPERTY OF MICHAEL H. BROWN & LONNIE F. BROWN and recorded in Plat Book at Page ; and that the property lines, walls and buildings are as shown hereon, and that the walls and buildings located on said lot do not encroach or project on adjacent street or property, and that no adjacent walls or buildings encroach on the said premises, and no power lines cross this property except as shown hereon.

15637

R. B. Bruce

R. B. Bruce, RLS #1952

CAROLINA SURVEYING CO.
112 Manly St., Greenville, S. C.

FILED
GREENVILLE CO. S. C.
NOV 18 2 46 PM '77
DONNIE S. TANKERSLEY
R.M.C.

GCTO ---1 NO18.77 1361

1.00CI

6-K-40

NOV 18 77

199-78

MICROFILMED